

Name **John Shine, Jr.**

Service No. **203**

Address **11 Utica Street**

11 UTICA STREET

Location

Comm. 12/31/57

Kind of Pipe

Size **6"**

Size of Main **8"**

~~XXXXXXXXXXXX~~ **New Service**

Location

Date	Material	Amount	Total	Date	Amount
	16.5' 6" V.C. Pipe @ 3.00		49 50	10-28-57	Deposit
				12-31-57	Refund
	Installed by contractor				\$ 150.00
	Bill owner when connected				73.30
					\$ 76.70
<i>11-16-57</i>	Labor	4.95			
	10% O.H.	.50	5.45		
	30' - 6" Transite pipe @ .70		21.00		
	1 hr. Trucking @ .75		.75		
			76.70		
<i>16.5</i>	Labor				

TOWN OF LEXINGTON—DEPT. OF PUBLIC WORKS
SEWER DIVISION

DATE 10-57.....

NO.


The undersigned applies for the construction of a particular sewer connecting No.....
 Street and hereby agrees to comply with the Rules and Regulations governing the construction and use of Particular
 Sewers, as now or at any future time established by the Board of Selectmen.

Am't of estimate \$.....

Am't Paid \$.....

..... Owner

Sketch of Service Here **11**

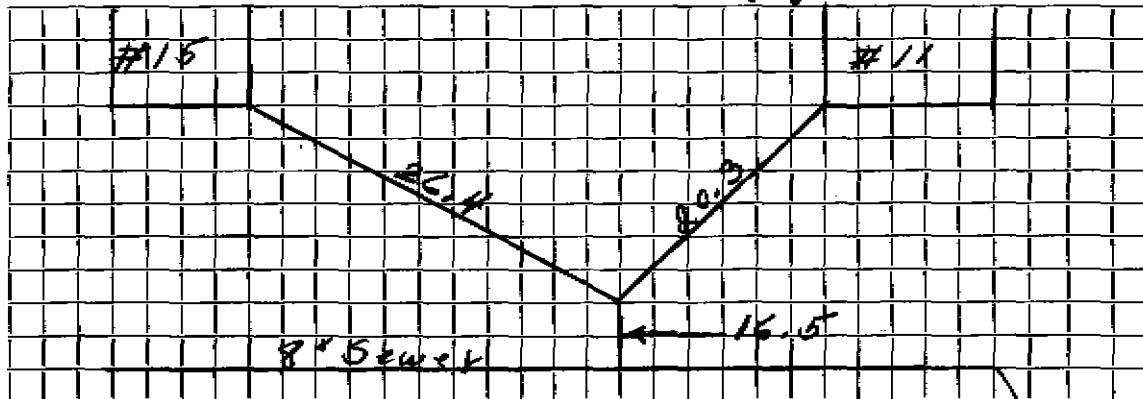

Connection made in..... Street.

Work completed.....19..

Remarks: