

Name William Setterland

Service No. 198

Address 12 Utica Street

12 UTICA STREET

Location

Comm. 12-2-57

Kind of Pipe

Size 6"

Size of Main 8"

~~Repair~~ New Service

Location

Date	Material	Amount	Total	Date	Amount
	20.0' 6" V.C. Pipe @3.00		60 00	10-21-57	Deposit 80.00
	Installed by contractor			12-2-57	Refund 9.23
	(Owner to be billed when connected)				<u>76.77</u>
11/11/57	labor		14 56		
	10% overhead		1 46		
	1 hr. trucking @.75		75		
			76 77		
	Labor				

TOWN OF LEXINGTON—DEPT. OF PUBLIC WORKS  
**SEWER DIVISION**

DATE *Oct 57* .....

NO. ....


The undersigned applies for the construction of a particular sewer connecting No. ....  
Street and hereby agrees to comply with the Rules and Regulations governing the construction and use of Particular  
Sewers, as now or at any future time established by the Board of Selectmen.

Am't of estimate \$ .....

Am't Paid \$ .....

..... Owner

Sketch of Service Here **12**

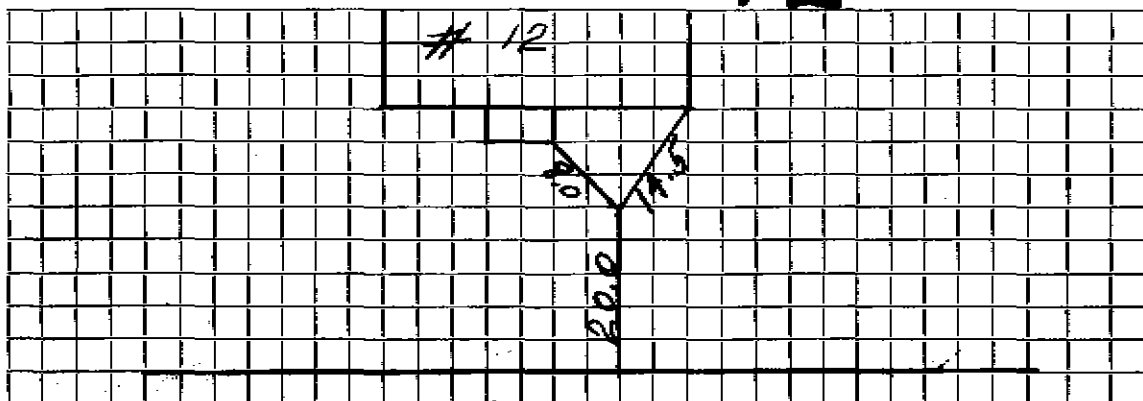

Connection made in ..... Street.

Work completed ..... 19..

Remarks: