

R. 50.50

Name

Cornelius P. Cronin

Service No. 215

Address

14 Utica Street

14 UTICA STREET

Location

Comm. 12/31/57

Kind of Pipe

Size 6"

Size of Main 8"

Repair—Renewal—New Service

Location

| Date | Material                            | Amount | Total | Date     | Amount            |
|------|-------------------------------------|--------|-------|----------|-------------------|
|      | 16.5' 6" V.C. Pipe @ 3.00           |        | 49 50 | 11-15-57 | Deposit \$ 100.00 |
|      | Installed by contractor             |        |       | 12-31-57 | Refund 50.50      |
|      | (Owner to be billed when connected) |        |       |          | \$ 49.50          |
|      | Labor                               |        |       |          |                   |

TOWN OF LEXINGTON—DEPT. OF PUBLIC WORKS  
SEWER DIVISION

DATE. Oct. 1957.....

NO. ....


The undersigned applies for the construction of a particular sewer connecting No.....  
Street and hereby agrees to comply with the Rules and Regulations governing the construction and use of Particular  
Sewers, as now or at any future time established by the Board of Selectmen.

Am't of estimate \$.....

Am't Paid \$.....

..... Owner

Sketch of Service Here 14

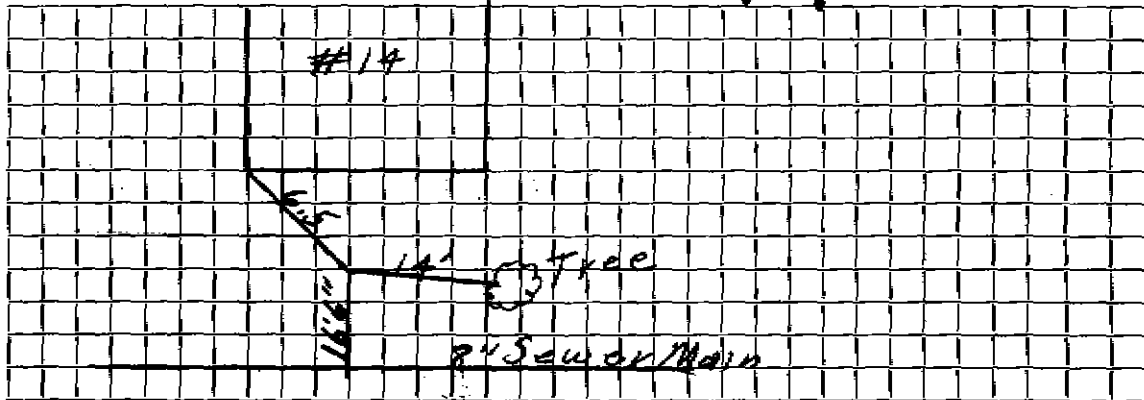

Connection made in ..... Street. Work completed.....19..

Remarks: