

Name **Howard G. Allison**

Service No. **46**

Address **15 Utica Street**

15 UTICA STREET

Location

Kind of Pipe

Size **6"**

Size of Main **8"**

~~Renewal~~ **New Service**

Location *Comm 11-10-58*

Date	Material	Amount	Total	Date	Amount
	16.5 6" V.C. Pipe @ 3.00		49.50	4-7-58	100.00
	Installed by contractor (Bill owner when connected)			11-10-58 <i>Retent</i> owe	<u>52.45</u>
5-9-58	Labor	50.06		12-5-58	52.45
	10% O.H.	5.01	55.07		<u>152.45</u>
	34' 6" Transite pipe @ .70		23.80		
	2 11 1/4" Transite Elbows @ 2.24		4.48		
	1 11 1/4" Transite Bend		5.10		
	2 hrs. Town Shovel @ 6.50		13.00		
	2 hrs. Trucking @ .75		1.50		
			<u>152.45</u>		
	Labor				

TOWN OF LEXINGTON—DEPT. OF PUBLIC WORKS

SEWER DIVISION

DATE. *Oct. 1957*.....

NO.

The undersigned applies for the construction of a particular sewer connecting No.
 Street and hereby agrees to comply with the Rules and Regulations governing the construction and use of Particular
 Sewers, as now or at any future time established by the Board of Selectmen.


Am't of estimate \$.....

Am't Paid \$.....

..... Owner

Sketch of Service Here

15

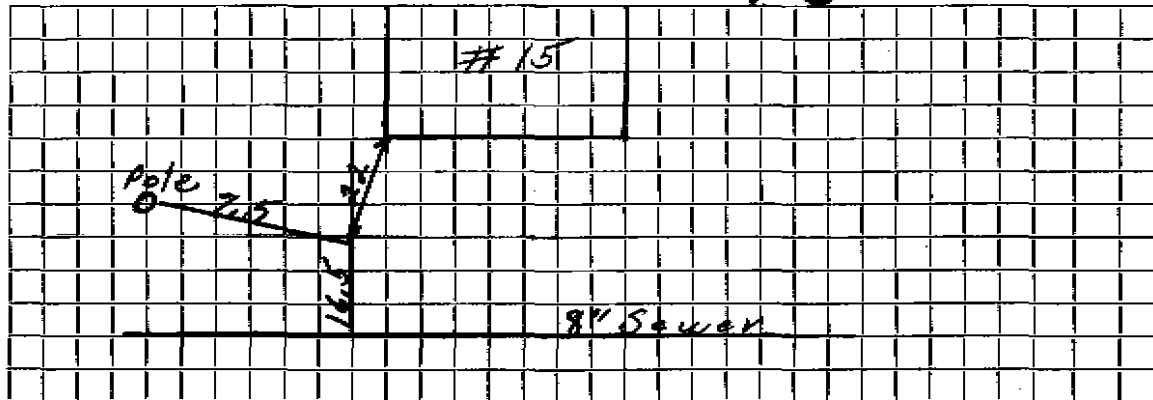

Connection made in Street.

Work completed 19..

Remarks: