

Name Antonio Bacigalupo

Service No. 90

Address 17 Utica St.,

17 UTICA STREET

Location

Kind of Pipe

Size 6"

Size of Main 8"

~~Service Change~~—New Service

Location Comm 11-13-61


Date	Material	Amount	Total	Date	Amount
3/22/61	Labor	94 90		2-20-61	Deposit 700 00
3/23/61	"	82 01		11-13-61	* Refund 12 32
3/24/61	"	78 95			687 68
3/25/61	"	49 58			
		305 44			
	10% O.H.	30 54	335 98	1 Hr. Trailer @ 3.00	3 00
196	6" Transite Pipe @.78		152.88	3 Hrs. Compressor @ 3.00	9 00
1	6" 90° Transite Elbow		5 40	2 Hrs. Loader @ 3.00	6 00
2	6" 11 1/4° Transite Elbows @ 224		4 48	2 4 X 4 Patch	32 00
1	6 X 8 Service Saddle		5.65		687 68
1	Sewer Manhole Cover & Frame		35 00		
3	Bags Cement @ 1.50		4 50		
24	Barrell Blocks		7 68		
12	#1, 2, 3 & 4 Batter Blocks		18 72		
150	Sewer Bricks @ 4.20 per 100		5 23		
4	Sticks Dynamite @ .26		1 04		
4	Blasting Caps @ .28		1 12		
6	Hrs. Town Shovels @ 6.50		39 00		
7	Hrs. Trucking @ 3.00		21 00	* Applied to WH #102	

DATE _____

TOWN OF LEXINGTON — BOARD OF PUBLIC WORKS

SEWER DIVISION

Sketch of Service Here

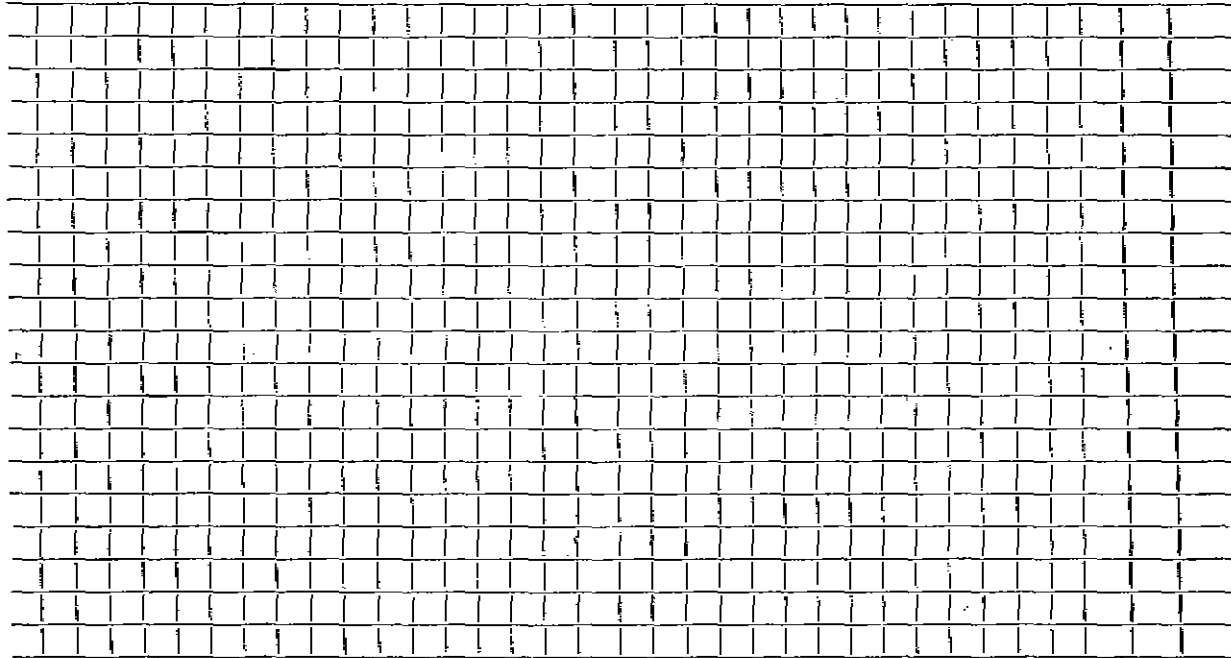

Connection made in Street. Work completed

Remarks:

.....

.....