

345 UTICA STREET

Location

Size of Main

Location

Size


NEW SERVICE

Date	Material	Amount	Total	Date	Amount
10-29-59	Labor	58.53		2-11-59	Deposit
10-30-59	"	58.53	117.06	11-9-59	Paid by SHEET III
	10% O.H.	11.71	11.71	1-1-60	Paid
10-29-59	100' 6" Transite pipe @.70		76.30		
1	Ceaspool Cover & Frame		10.50	10/30/6"	V.C. Pipe
1	11' 0" Transite Bend		5.10		
150	Sewer Brick @4.20 per 100		6.30		
2	Bags Cement @1.50		3.00		
4	hrs. Pippin Shovel @4.50		18.00		
30	X 3 Patch		30.00		
1	ton Brick Sand @1.00 per ton		1.00		
3	hrs. Trucking @.75		2.25		
	PREVIOUS CHARGE		49.50		
			530.72		
				Bill sent 11-25-59	\$3.62

DATE _____

TOWN OF LEXINGTON — BOARD OF PUBLIC WORKS
SEWER DIVISION

Sketch of Service Here **36-5**

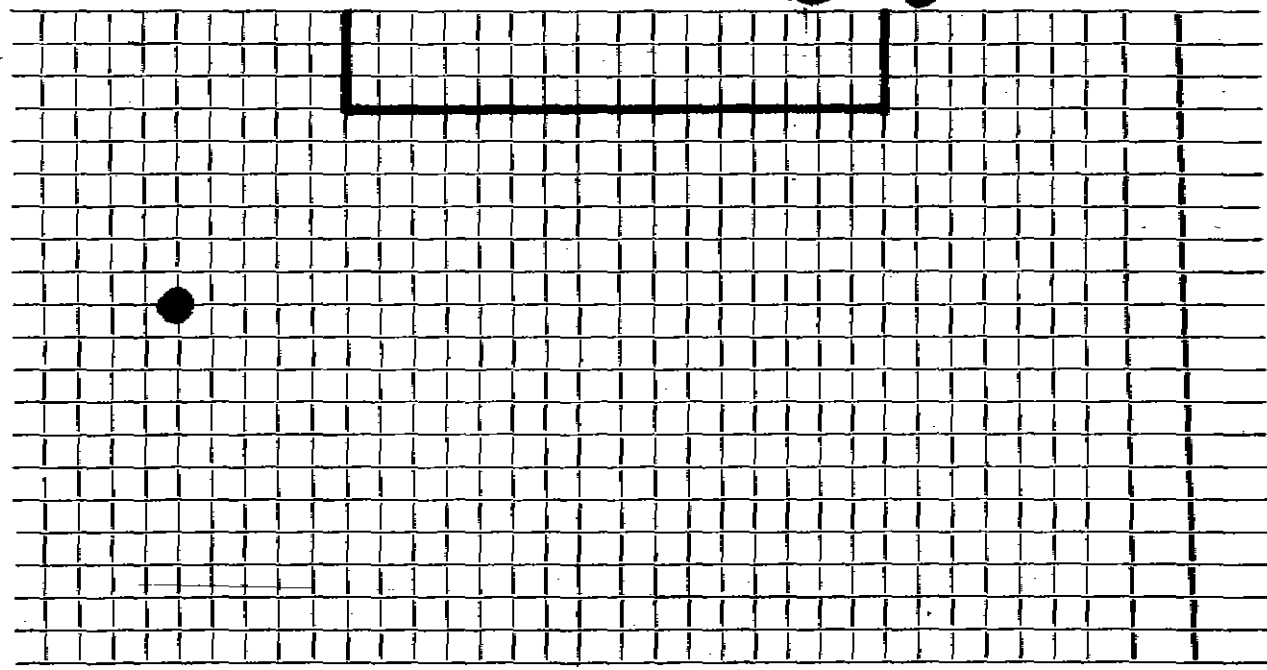

Connection made in Street. Work completed

Remarks:
.....
.....