


DATE 4/26/21

TOWN OF LEXINGTON — BOARD OF PUBLIC WORKS  
SEWER DIVISION

Sketch of Service Here

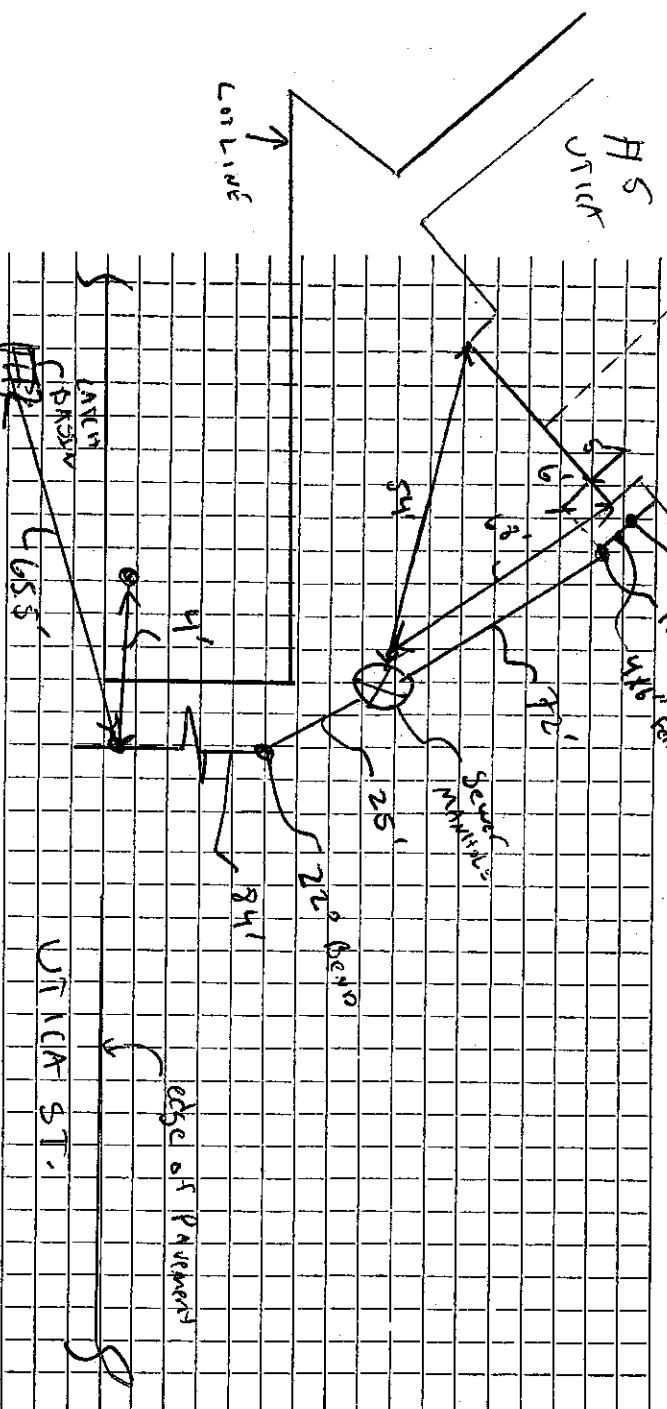

Connection made in ... UTICA Street ... Work completed ... Renewal

Remarks: .....

Name J. McLashlin Inc.

Service No. Ww2122

Address 3 UTICA ST

Location

Kind of Pipe SDR-35 Size 6 Size of Main 8

Repair ~~Renewal~~ New Service

Location

Date	Material	Amount	Total	Date	Material	Amount
4/25/21	ROAD → HOUSE				SDR-35-6"	6'
	6x8 FERNCO	①			4x6" FERNCO	①
	SDR-35 6"	84ft			4" PVC	2'
	6" 22° BEND	①			4" cleanout	①
	SDR-35 6"	25ft			4" PVC	5'
	MANHOLE	①				
	SDR-35 6"	68ft				
	6" 11° BEND	①				