


DATE 4/28/2021

TOWN OF LEXINGTON — BOARD OF PUBLIC WORKS  
SEWER DIVISION

Sketch of Service Here

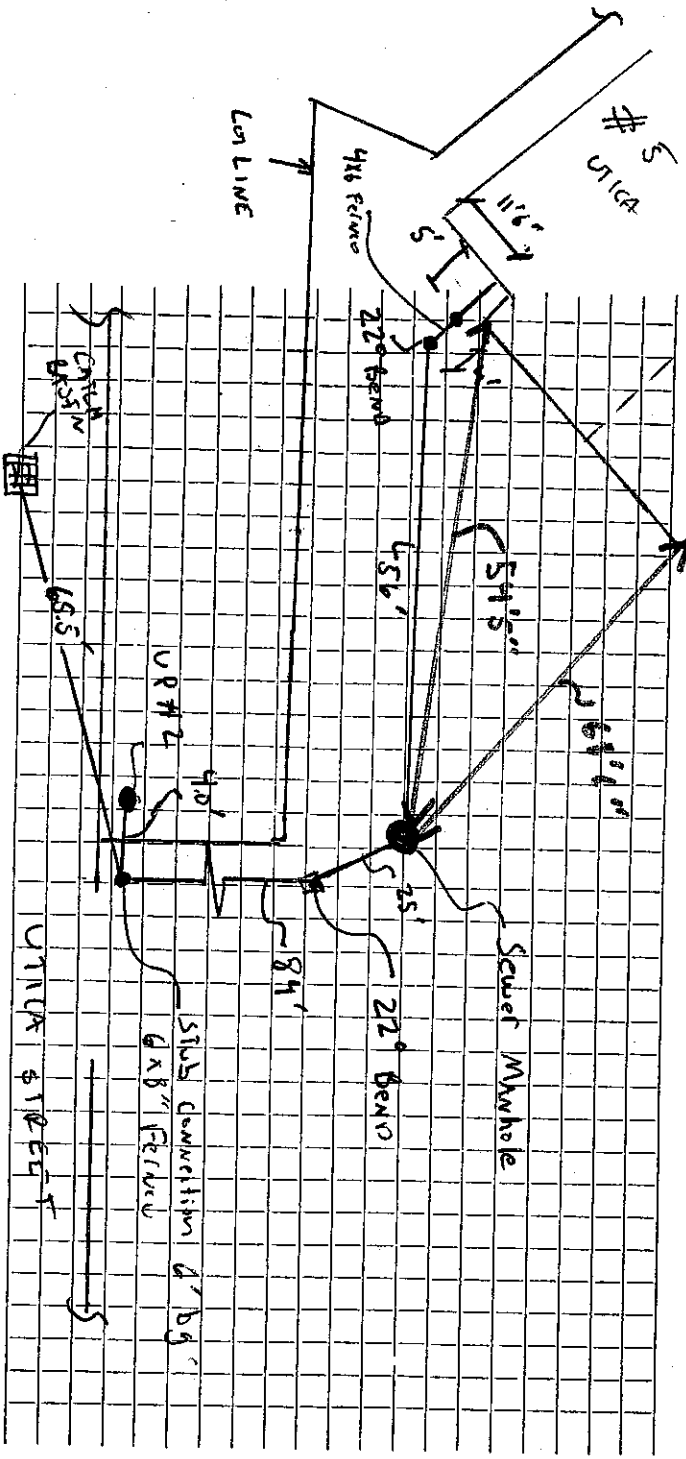

Connection made in UTICA Street. Work completed  
Remarks: \* Sewer Renewal for 315 UTICA

Name J. McLaughlin INC.

Service No. WW-21-23

Address 5 UTICA ST.

Location

Kind of Pipe SOR-35 Size 6" Size of Main 8"

Repair—Renewal—New Service

Location

Date	Material	Amount	Total	Date	MATERIAL	Amount
4/26/21	ROAD → HOUSE			4/26/21	SOR-35 6"	2'
	6x8 FerriCo	①			4x6 FerriCo	②①
	SOR-35 6"	84FT			4" PVC	2'
	6" 220 BEND	①			4" Cleamout	①
	SOR-35 6"	256FT			4" PVC	45'
	MANHOLE	①				
	SOR-35 6"	56'				
	6" 220 BEND	①				