

Name Francis Corbett

Service No. 103

Address 6 Utica Street

6 UTICA STREET

Location

FEB 12 1973

Kind of Pipe

Size 6"

Size of Main 8"

Repair—Renewal—New Service

Lexington Sewerage #2210

Location

Date	Material	Amount	Total	Date	Amount
	16.5 6" V.C.Pipe @ 3.00 Installed by contractor (Owner to be billed when connected)		49 50	7-11-72	Deposit 49 50
10/10/72	7' 6" Transite				
	5' 4" Cast Iron				
	Labor				

TOWN OF LEXINGTON—DEPT. OF PUBLIC WORKS
SEWER DIVISION

DATE.. *Oct.*.....

NO.

The undersigned applies for the construction of a particular sewer connecting No.....
Street and hereby agrees to comply with the Rules and Regulations governing the construction and use of Particular
Sewers, as now or at any future time established by the Board of Selectmen.


Am't of estimate \$.....

Am't Paid \$.....

..... Owner

Sketch of Service Here

6

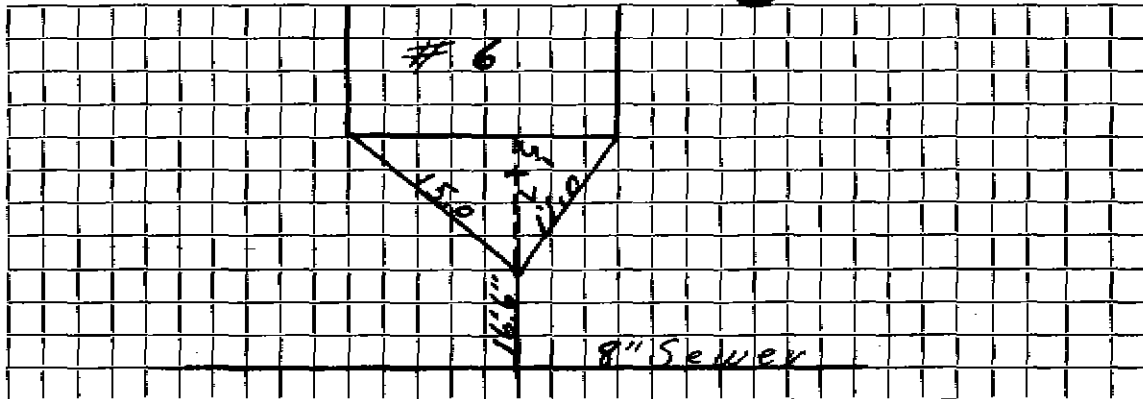

Connection made in..... Street.

Work completed..... 19..

Remarks: