

Name James Redmond

Service No. 41

Address 9 Utica Street

9 UTICA STREET

Location

Kind of Pipe Lexington Sewerage Co.

Size

Size of Main

~~Sanitary Sewer~~ New Service Permit #267

Location MAY 17 1965

Date	Material	Amount	Total	Date	Amount
	16.5 " V.C. pipe @ 3.00 Installed by contractor (Owner to be billed when connected)		49 50	4-29-65	49 50
4-29-65	10' 6" Transite pipe				
	Labor				

Deposit

TOWN OF LEXINGTON—DEPT. OF PUBLIC WORKS
SEWER DIVISION

DATE... *Oct. 1957*

NO.


The undersigned applies for the construction of a particular sewer connecting No.
 Street and hereby agrees to comply with the Rules and Regulations governing the construction and use of Particular
 Sewers, as now or at any future time established by the Board of Selectmen.

Am't of estimate \$.....

Am't Paid \$.....

..... Owner

Sketch of Service Here **9**

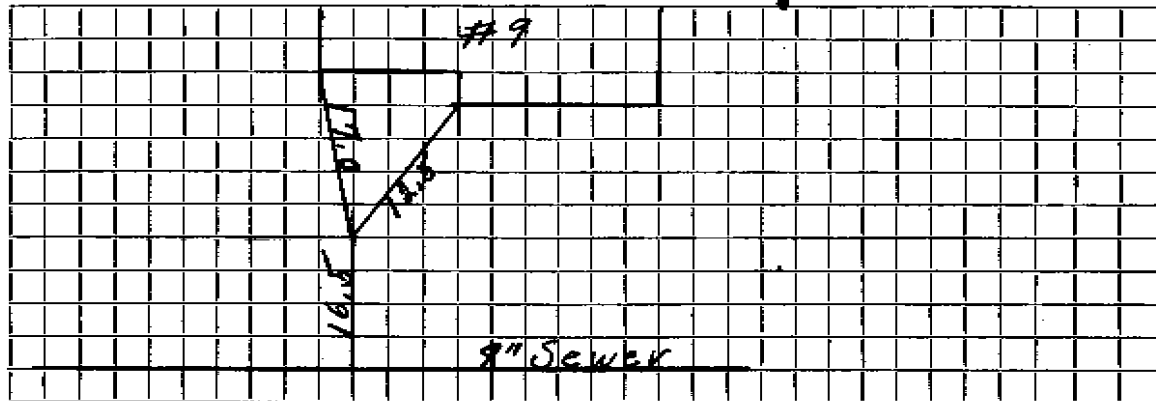

Connection made in Street.

Work completed 19..

Remarks: