

Service No. 233

Name Robert L. Brown

Address 1 Vaille Avenue

Vaille Avenue

Location

Kind of Pipe

Size 6"

Size of Main 8"

XXXXXXXXXXXXX-New Service

Location

Camden 12-12-60


Date	Material	Amount	Total	Date	Amount
10-26-60	Labor	83.20		4-20-60	200.00
10-21-60	"	16.00		12-12-60	4.72
	10% O.H.	9.92	109.12		195.28
59'	6" Transit pipe @.78		46.02		
5	ton 3/4" Stone @1.50		7.50		
1	6" 90° Transit Elbow		5.40		
1	11/2" Transit Elbow		2.24		
2	hrs. Tonn Shovel @6.50		13.00		
3	hrs. Trucking @3.00		9.00		
1	hr. Trailer @3.00		3.00		
			195.28		

DATE \_\_\_\_\_

TOWN OF LEXINGTON — BOARD OF PUBLIC WORKS

SEWER DIVISION

Sketch of Service Here /

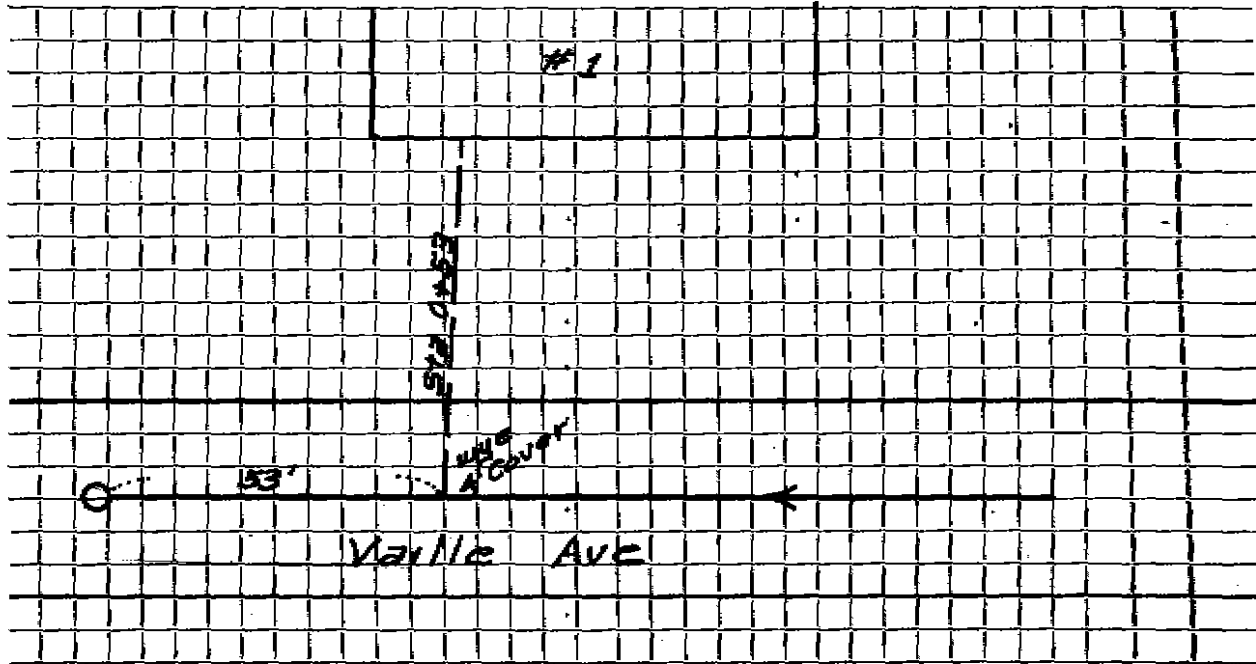

Connection made in ..... Street. Work completed .....

Remarks: .....  
.....  
.....