

Name F. A. Marriott

Service No. 52

Address 10 Vaille Avenue

10 Vaille Avenue

Location

Kind of Pipe

Size 6"

Size of Main 8"

~~REPLACEMENT~~ New Service

Location Conn 6-19-61


Date	Material	Amount	Total	Date		Amount
5-19-61	Labor	56.71		5-19-61	Deposit	200.00
	10% O.H.	5.67	62.38	6-19-61	Retund	72.93
36'	6" Transite pipe @.78		28.08			127.07
1	90° Transite Elbow		5.40			
1	22½° Transite Bend		6.21			
2	hrs. Town Shovel @6.50		13.00			
3	hrs. Trucking @3.00		9.00			
1	hr. Trailer @3.00		3.00			
			127.07			

DATE _____

TOWN OF LEXINGTON — BOARD OF PUBLIC WORKS

SEWER DIVISION

Sketch of Service Here **10**

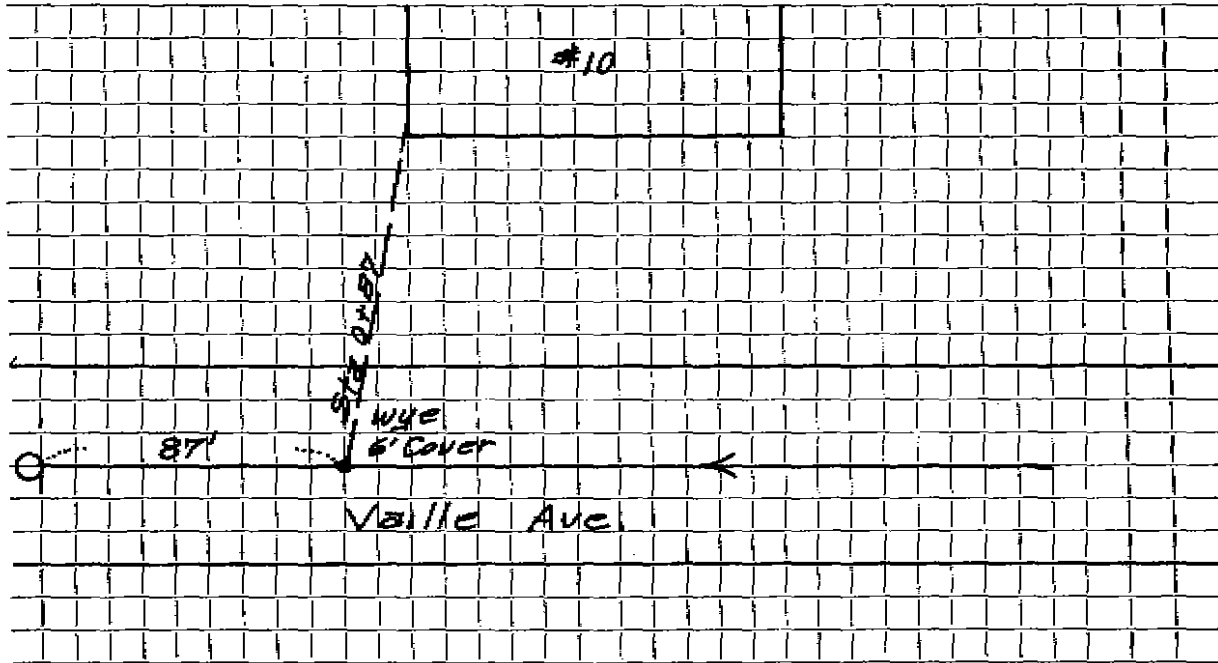

Connection made in Street. Work completed

Remarks:

.....

.....