

Name

Service No.

Address

12 VAILLE

Location

Kind of Pipe

Size

Size of Main

Repair—Renewal—New Service

Location

Date

Material

Amount

Total

Date

Amount

7-20-05

10' - 4" PVC

4x6 PVC to PVC fitting


35' - 6" PVC

6x6x6 wye cleanout

DATE \_\_\_\_\_

TOWN OF LEXINGTON — BOARD OF PUBLIC WORKS

SEWER DIVISION

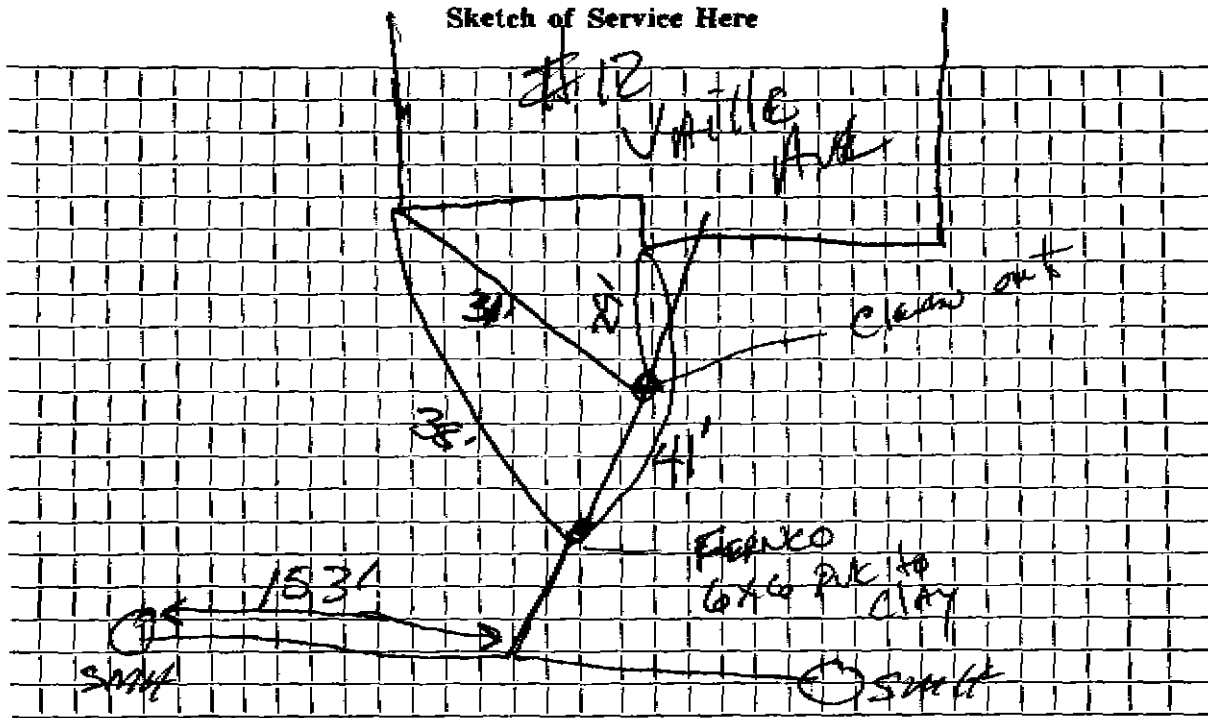

Connection made in ..... Street. Work completed .....

Remarks: .....

.....

.....