

Name Stanley Phillips

Service No. 227

Address 15 Valle Avenue

15 Valle Avenue

Location

Kind of Pipe

Size 6"

Size of Main 8"

~~REPAIRS~~ - New Service

Location Coal Valley

Date	Material	Amount	Total	Date	Amount
-28-60	Labor	64.00		4-20-60	200.00
	10% O.H.	6.40	70.40	4-25-60	13.24
54'	6" Transite pipe @.78		42.72	Retained	136.76
1	6" Transite Elbow		2.24		
2	hrs. Tonn Shovel @5.50		11.00		
2	hrs. Trucking @3.00		6.00		
1	hr. Loader @3.00		3.00		
			<u>136.76</u>		


DATE _____

TOWN OF LEXINGTON — BOARD OF PUBLIC WORKS

SEWER DIVISION

Sketch of Service Here

15

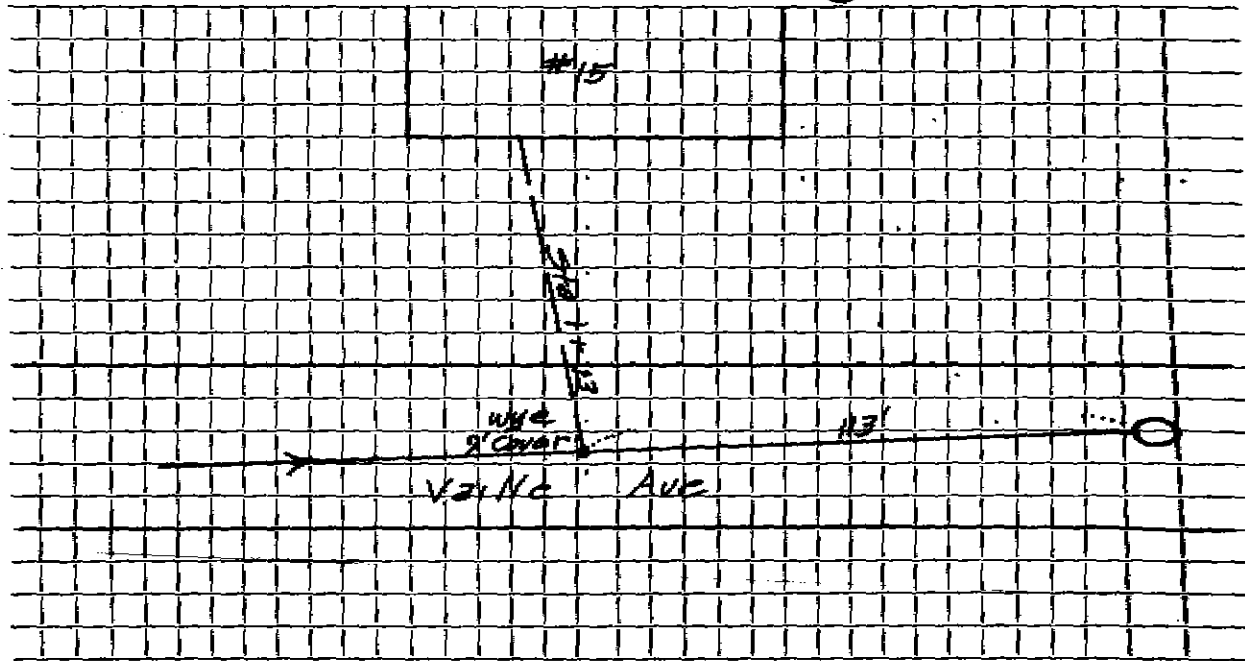

Connection made in Street. Work completed

Remarks:

.....

.....