

Name J.E. Cummings

Service No. 229

Address 20 Vaille Ave.,

20 Vaille Avenue

Location

Kind of Pipe

Size 6"

Size of Main 8"

Repair—Renewal—New Service

Location *Con. 12-12-60*


Date	Material	Amount	Total	Date	Amount
11/2/60	LABOR	79 65		<i>11-20-60</i>	<i>Deposit</i>
11/19/60	"	15 78		<i>12-12-60</i>	<i>Ret. fund</i>
			95 43		
	10% over head		9 54		
			104 97		
	55' 6" Transite pipe @ .78		42 90		
	1 11 1/4" Tran. Elbow		2 24		
	1 6" 90° Tr. Elbow		5 40		
	1 6" Duplex Adapt.		1 90		
	3 hr town shovel	6.50	19 50		
	3 hr trucking @ 3.00		9 00		
			185 91		

DATE _____

TOWN OF LEXINGTON — BOARD OF PUBLIC WORKS

SEWER DIVISION

Sketch of Service Here **20**

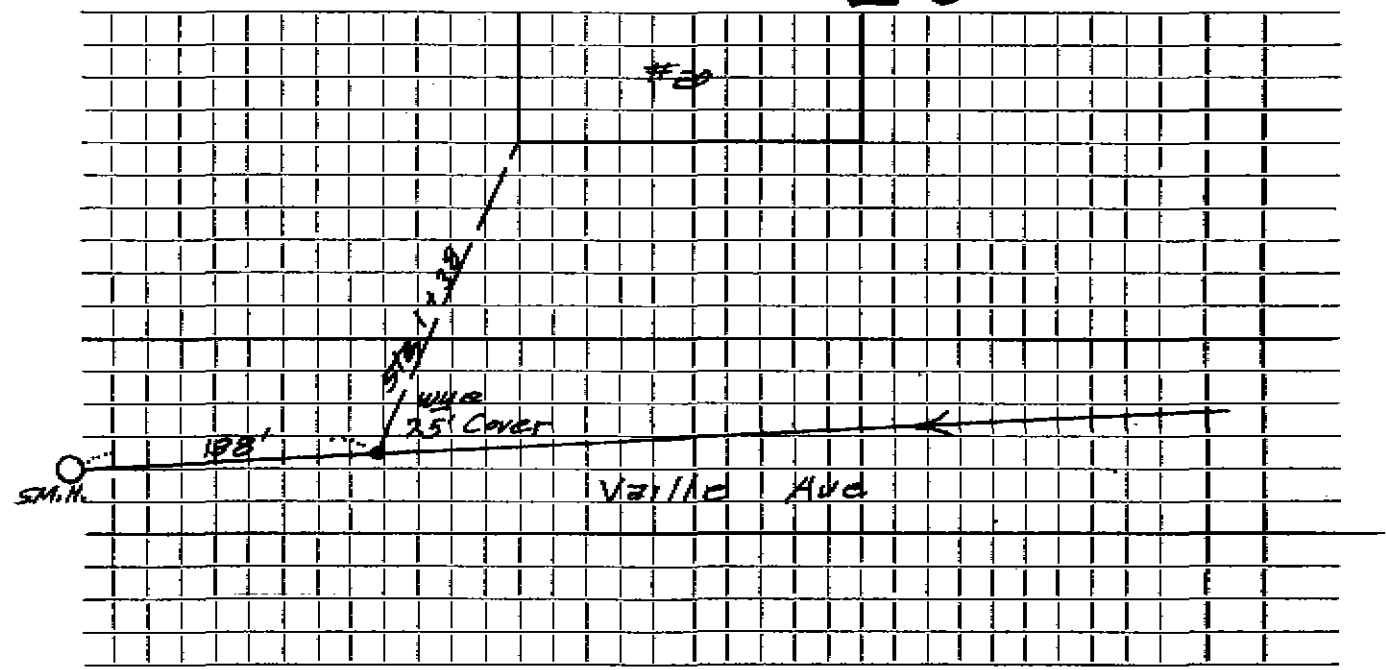

Connection made in Street. Work completed

Remarks:
.....
.....