

Name **Malcom McKenzie**Service No. **37**Address **24 Vaille Avenue****24 Vaille Avenue**

Location

Kind of Pipe

Size **6"**Size of Main **8"**~~Repair~~ **New Service**Location *Conn 619-61*


Date	Material	Amount	Total	Date	Amount
5-3-61	Labor	60.00		4-26-61	150.00
5-5-61	"	13.41	73.41	6-19-61	19.3
	10% O.H.	7.34	80.75		148.09
39'	6" Transite pipe @.78		30.42		
1	6" Transite 90° Elbow		5.40		
3	hrs. Town Shovel @6.50		19.50		
3	hrs. Trucking @3.00		9.00		
1	hr. Loader @3.00		3.00		
			148.07		

DATE _____

TOWN OF LEXINGTON — BOARD OF PUBLIC WORKS

SEWER DIVISION

Sketch of Service Here **24**

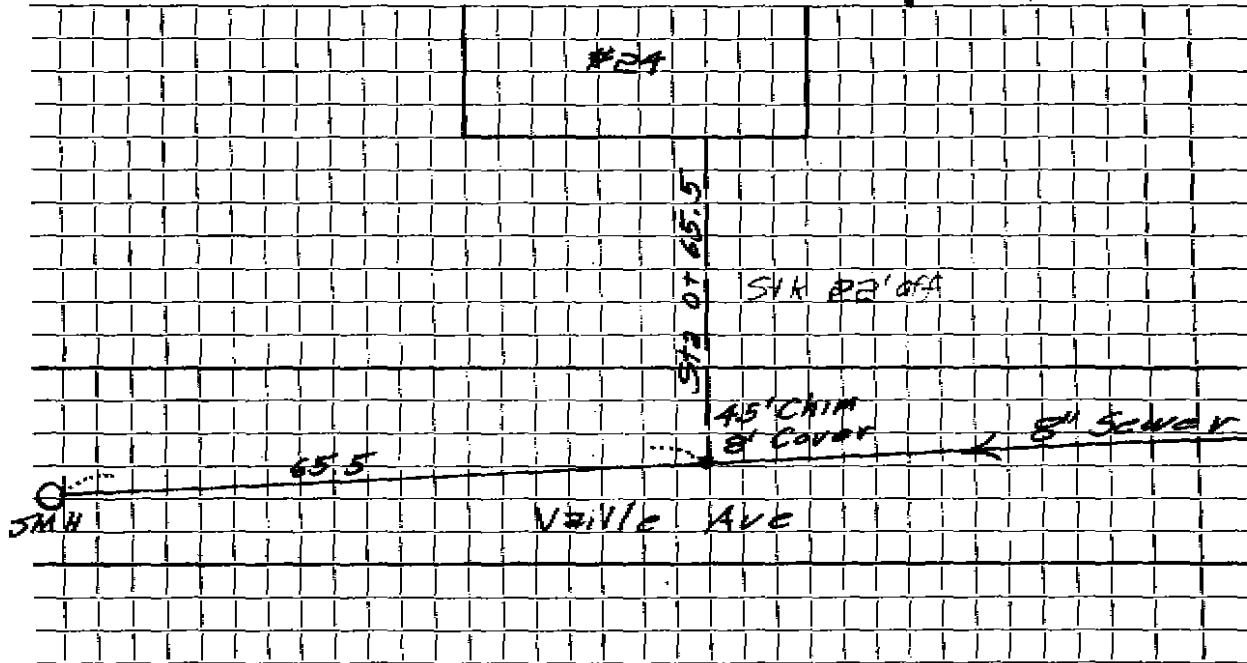

Connection made in Street. Work completed

Remarks:
.....
.....