

Name Steven P. Dougherty

Service No. 76 (75')

Address # ~~28~~ Vaille Ave

28 Vaille Avenue

Location

Kind of Pipe

Size 6"

Size of Main 8"

~~W.O. # 6754~~ New Service W.O. # 6754

Lexington Sewerage \$2700

Location AUG 16 1976

Date	Material	Amount	Total	Date	Amount
6/12/68	Labor	41 40		8-6-75	87 23
	10% O.H.	4 14			
			45 54		
	20' transite @ .88		17 60		
	1 90° elbow		4 09		
	2 hrs. shovel @ 6.50		13 00		
	1 hr. loader		4 00		
	1 hr. trucking		3 00		
		TOTAL COST	\$87 23		
8/13/75	15' 6" Transite Pipe				
	10' 4" Cast Iron Pipe				


DATE _____

TOWN OF LEXINGTON — BOARD OF PUBLIC WORKS

SEWER DIVISION

Sketch of Service Here **28**

B.M. Hyd @ Ho. #28
El. - 100.00
Cellar floor El. - 98.25
Inr Service - 96.25

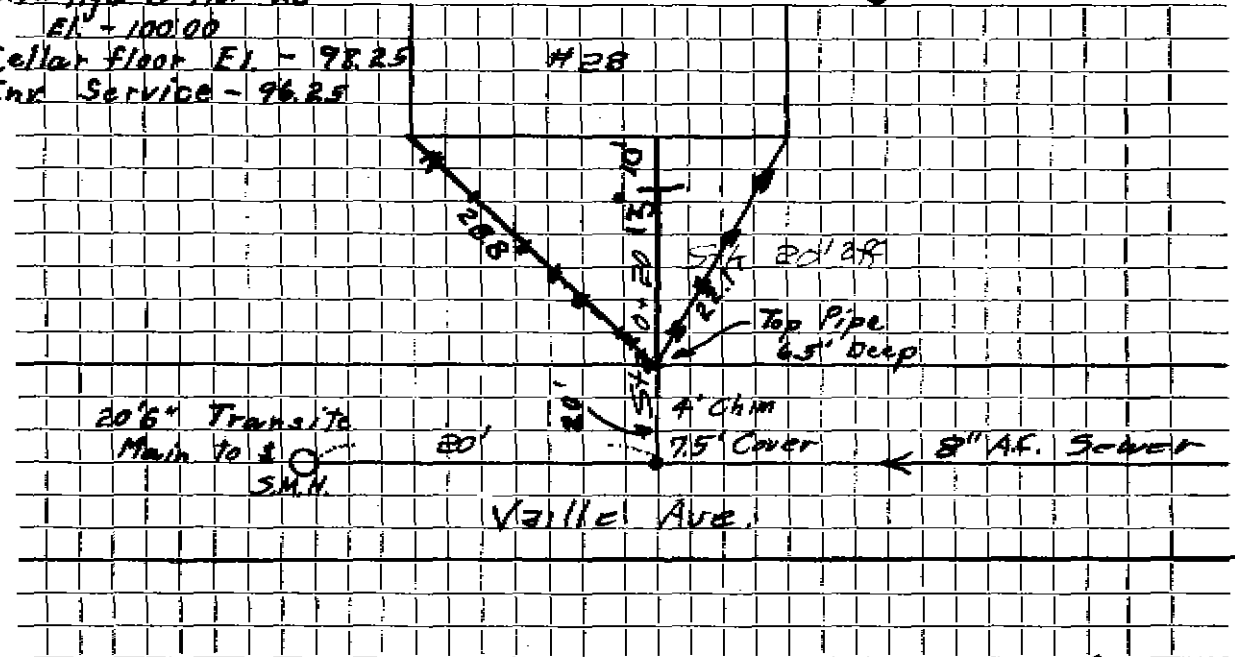

Connection made in **#28 VAILLE** Street. Work completed **8/13/75**

Remarks: