

Name William McMahon

Service No. 148

Address 29 Vaile Avenue

29 Vaile Avenue

Location

Kind of Pipe

Size 6"

Size of Main 8"

~~REPLACEMENT~~ New Service W.O. # 6754

Valeri #1801

Location


APR 21 1971

Date	Material	Amount	Total	Date	Amount
6/12/68	Labor	50 58		12-4-70	Deposit
	10% O.H.	5 06	55 64		103 78
25'	6" Transite @		22 00		
1	90° elbow		4 09		
2	doz. bricks		50		
1	bag cement		1 55		
2	hrs. shovel		13 00		
1	Hrs. loader		4 00		
1	hr. trucking		3 00		
		TOTAL COST	\$103 78		
1/8/70	127' 6" Transite pipe				
	9' 4" Cast Iron pipe				

DATE _____

TOWN OF LEXINGTON — BOARD OF PUBLIC WORKS

SEWER DIVISION

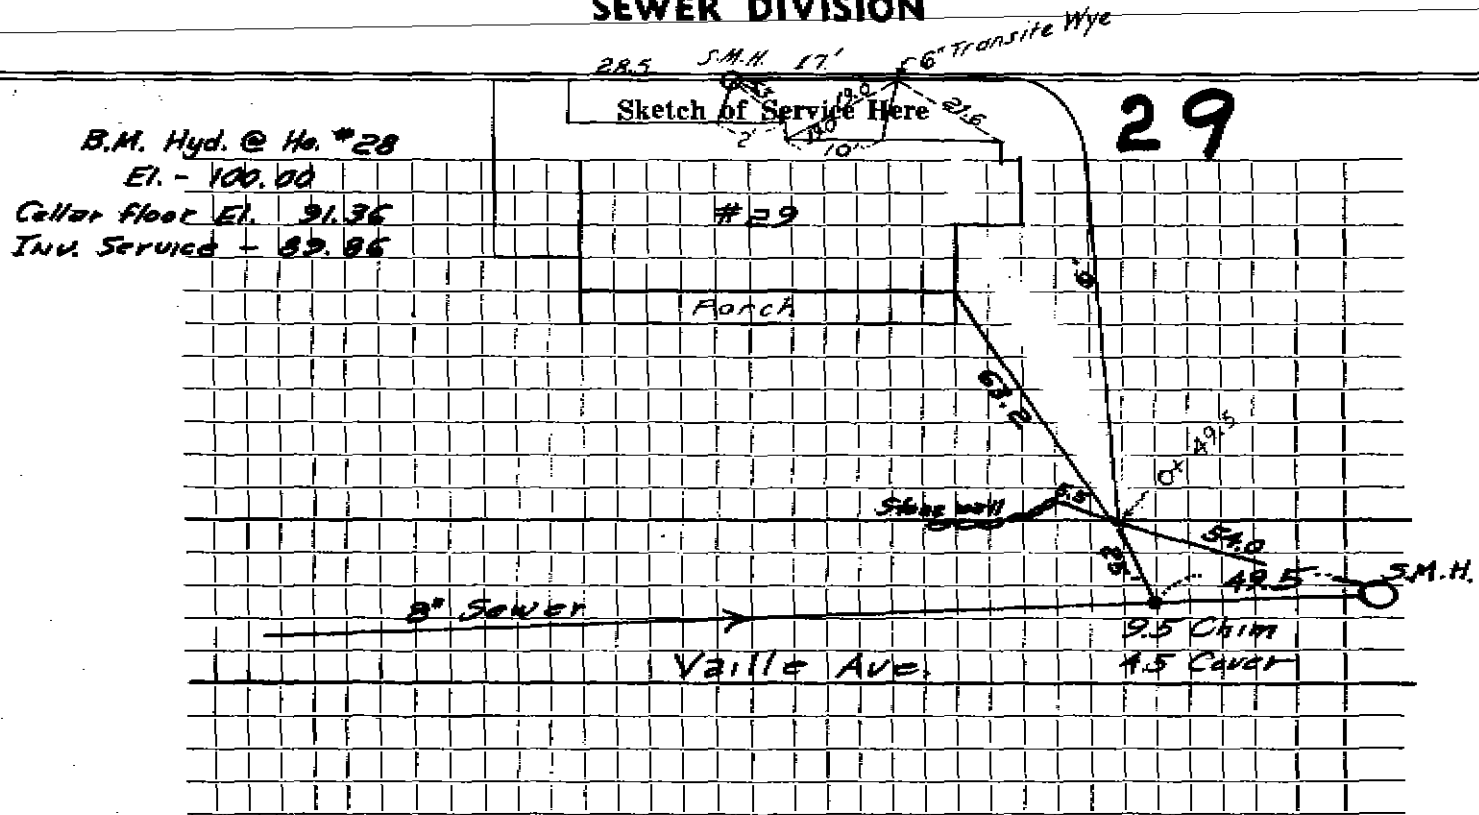

Connection made in Street. Work completed

Remarks:
.....
.....