

Name **Ether Samson**

Service No. **141**

Address **35 Vaille Avenue**

35 Vaille Avenue

Location

Kind of Pipe

Size **6"**

Size of Main **8"**

~~REPLACEMENT~~ **New Service** W.O. # 6754 Valeri #1514

Location **APR 6 1970**

Date	Material	Amount	Total	Date	Amount
6/12/68	Labor	41 40		11-29-69	93 96
	10% O.H.	4 14	45 54	<i>Deposit</i>	
23'	6" transite @ .88		20 24		
1	90° Elbow		4 09		
1	1 1/4 Bend		4 09		
2	hrs. shovel		13 00		
1	hr. loader		4 00		
1	hr. trucking		3 00		
		TOTAL COST	\$93 96		
12-3-69	30' 6" Transite pipe				
	10' 4" Cast Iron pipe				


DATE _____

TOWN OF LEXINGTON — BOARD OF PUBLIC WORKS

SEWER DIVISION

Sketch of Service Here **35**

B.M. Hyd. @ Ho. 28
E.I. - 102.00
Cellar Floor - 91.76
Ink Service - 91.16'

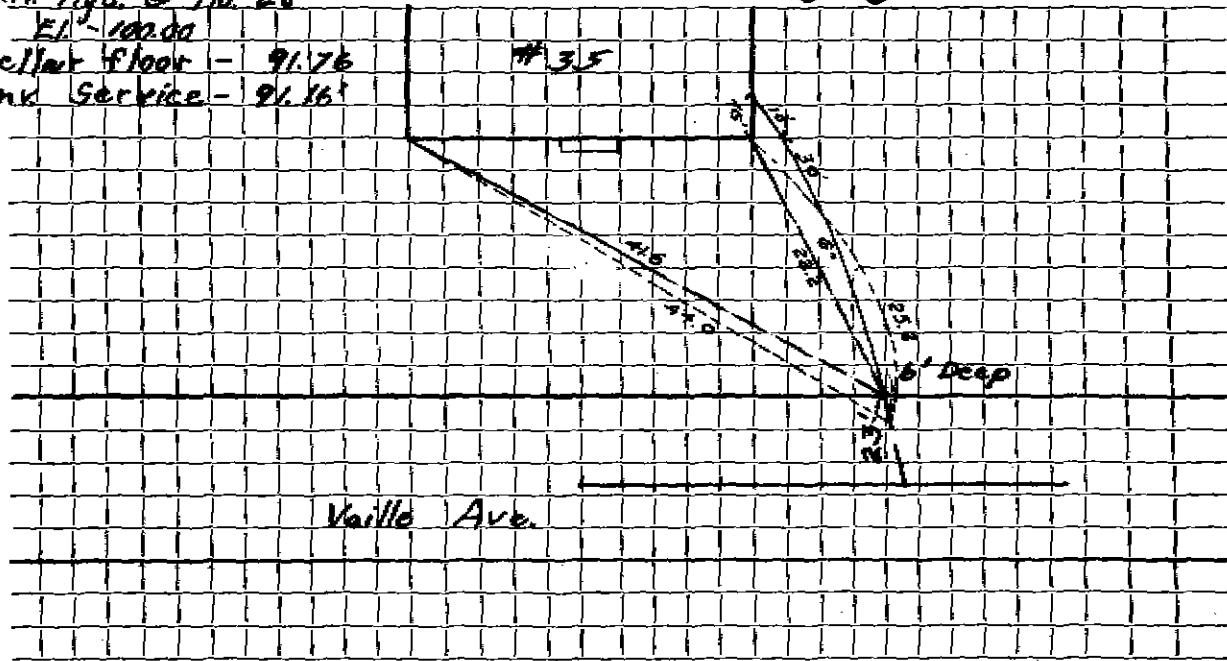

Connection made in Street. Work completed

Remarks:
.....
.....