

Name James E. Day

Service No. 137

Address 36 Vaille Avenue

36 Vaille Avenue

Location

Kind of Pipe

Size 6"

Size of Main 8"

~~Repair~~ ~~Renewal~~ — New Service

Location Comm 12-4-61


Date	Material	Amount	Total	Date	Amount
10/13/61	Labor	67 73		10-2-61	Deposit 175 00
10/14/61	"	38 60		12-14-61	Paid 7 98
		106 33			182 98
	10% O.H.	10 63	116 96		
	43' 6" Transite Pipe @ .78		33 54		
	2 1 1/2" Transite Elbows @ 2.24		4 48		
	2 Hrs. Town Shovel @ 6.50		13 00		
	3 Hrs. Trucking @ 3.00		9 00		
	1 Hrs. Trailer @ 3.00		3 00		
	1 Hrs. Trojan Loader @ 3.00		3 00		
			182 98		
				10/9/69	Posts
					Bill sent 2.00

DATE \_\_\_\_\_

TOWN OF LEXINGTON — BOARD OF PUBLIC WORKS

SEWER DIVISION

Sketch of Service Here **36**

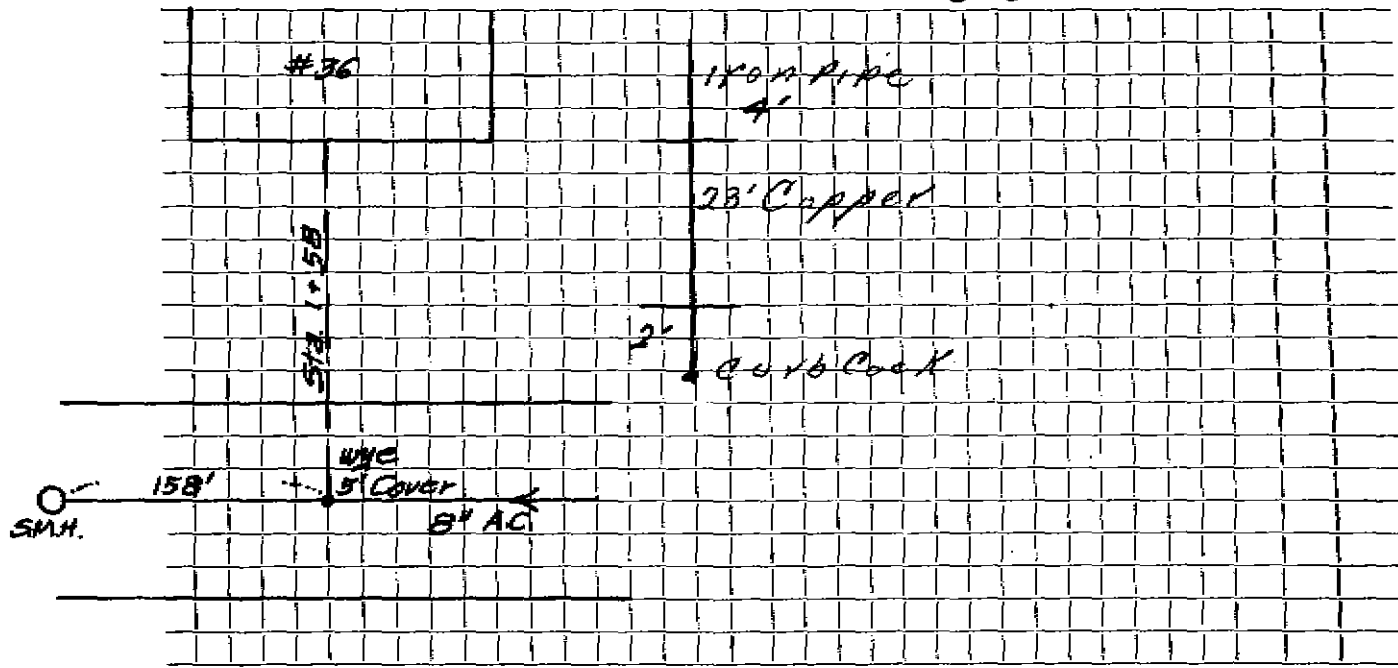

Connection made in ..... Street. Work completed .....

Remarks: .....

.....

.....