

Name Robert Koff

Service No. 128

Address 37 Vaille Ave.,

37 Vaille Avenue

Location

Kind of Pipe

Size 6"

Size of Main 8"

~~REPAIR~~ - New Service WO#8223

Location Comm 2-10-64


Date	Material	Amount	Total	Date	Amount
0/15/63	Labor	65 46		10-2-63	300 00
	10% O.H.	6 55	72 01	2-11-64	108 38
	66' 6" Transite Pipe @ .82		54 12		191 62
	1 6" Transite Adapter		1 90		
	1 11 1/4" Transite Bend		4 09		
	7 Yds. Loam @ 3.00		21 00		
	5 Hrs. Town Shovel @ 6.50		32 50		
	2 Hrs. Trucking @ 3.00		6 00		
2-22-65	Repair		191 62		
	10' 6" Transite				
	1 6"-11 1/4" Bend				
	1 6"-22 1/2" Bend				

DATE \_\_\_\_\_

TOWN OF LEXINGTON — BOARD OF PUBLIC WORKS

SEWER DIVISION

Sketch of Service Here **37**

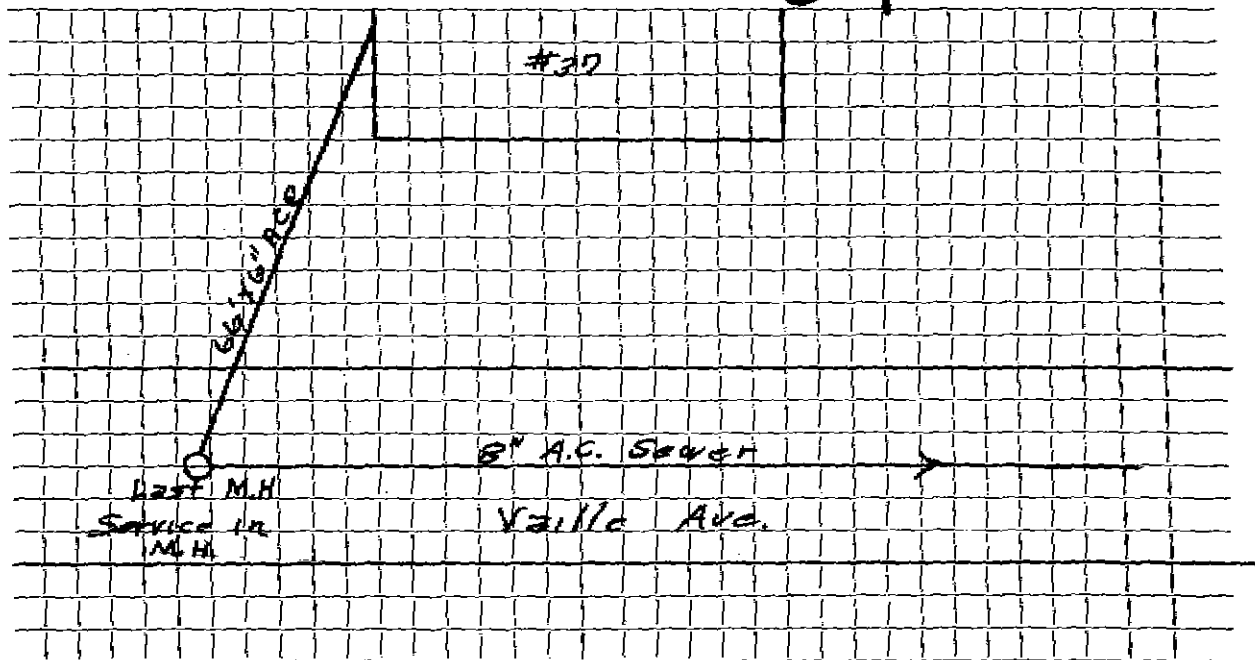

Connection made in ..... Street. Work completed .....

Remarks: .....

.....