


DATE 12-8-82

TOWN OF LEXINGTON — BOARD OF PUBLIC WORKS

SEWER DIVISION

38

Sketch of Service Here

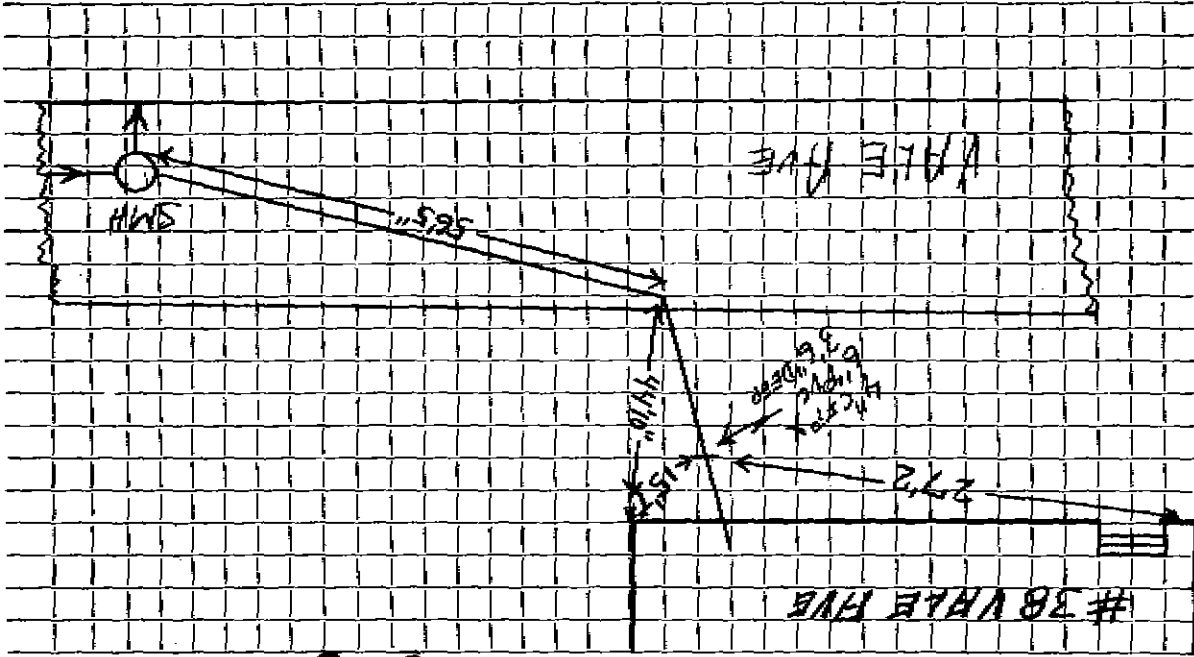

Work completed 12-8-82

Street

Connection made in VALE AVE

Remarks: