

Name **Pond Realty Trust**

Service No.

Address **39 Vaille Avenue**

Lot #32 **39 Vaille Avenue** Location

Kind of Pipe **DeFlice Bros. Permit #A43**

Size **6"**

Size of Main **8"**

Repair—Renewal—New Service

Location


Date	Material	Amount	Total	Date	Amount
-15-65 50'	6" Transite pipe				

DATE _____

TOWN OF LEXINGTON — BOARD OF PUBLIC WORKS

SEWER DIVISION

Sketch of Service Here **39**

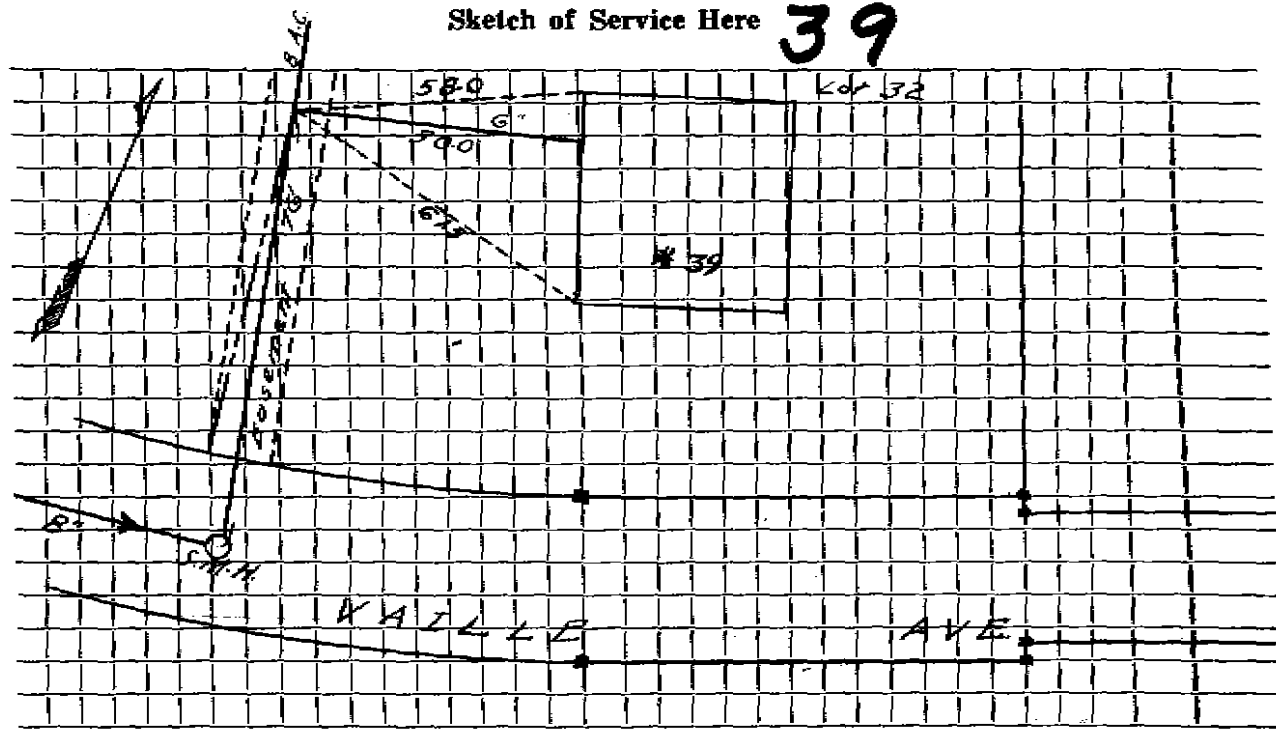

Connection made in Street. Work completed

Remarks:
.....
.....