

Name Pond Realty Trust

Service No.

Address 41 Vaille Avenue

Lot #33 41 Vaille Avenue Location

Kind of Pipe

Size 6"

Size of Main 8"

~~Repair~~ ~~Renewal~~ — New Service

W.M. Burns Permit #177
DeFlice Bros #AAA

Location

Date		Material	Amount	Total	Date	Amount
-13-65	18'	Sewer into easement 6" Transite pipe				


DATE _____

TOWN OF LEXINGTON — BOARD OF PUBLIC WORKS

SEWER DIVISION

Sketch of Service Here

41

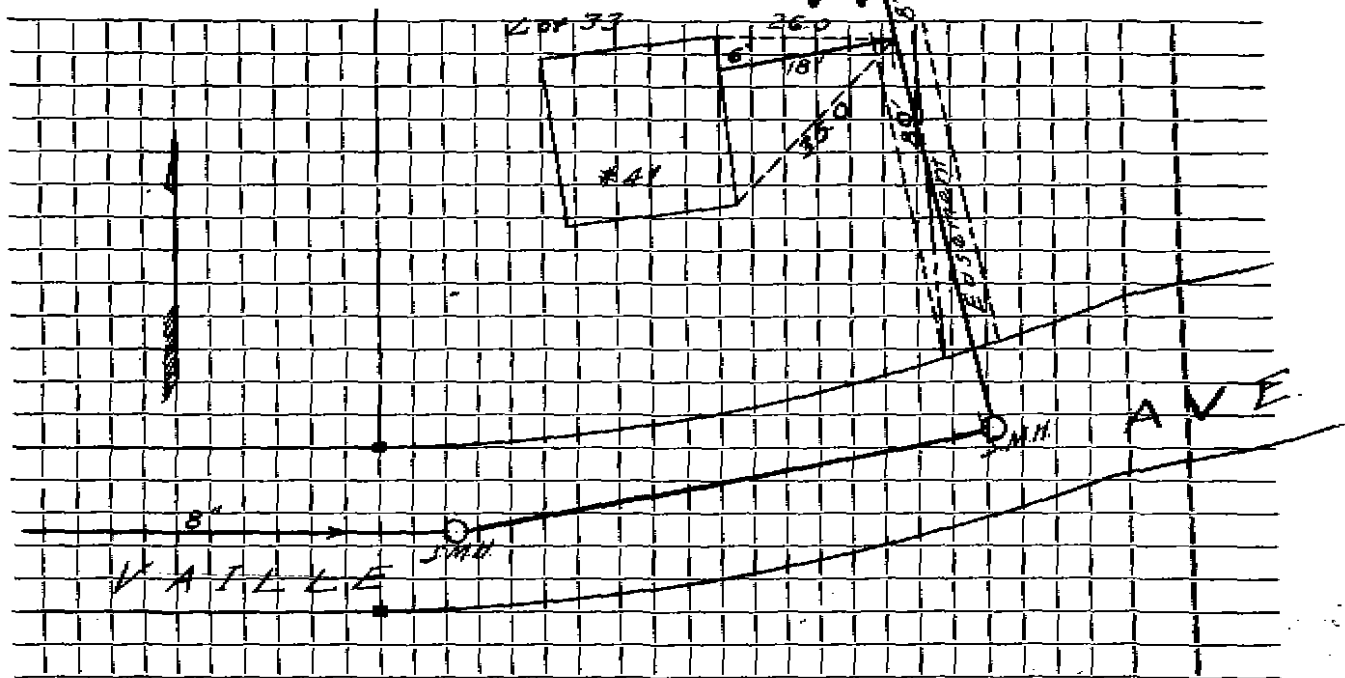

Connection made in Street. Work completed

Remarks:

.....

.....