


DATE 10-26-01

TOWN OF LEXINGTON — BOARD OF PUBLIC WORKS

SEWER DIVISION

Sketch of Service Here

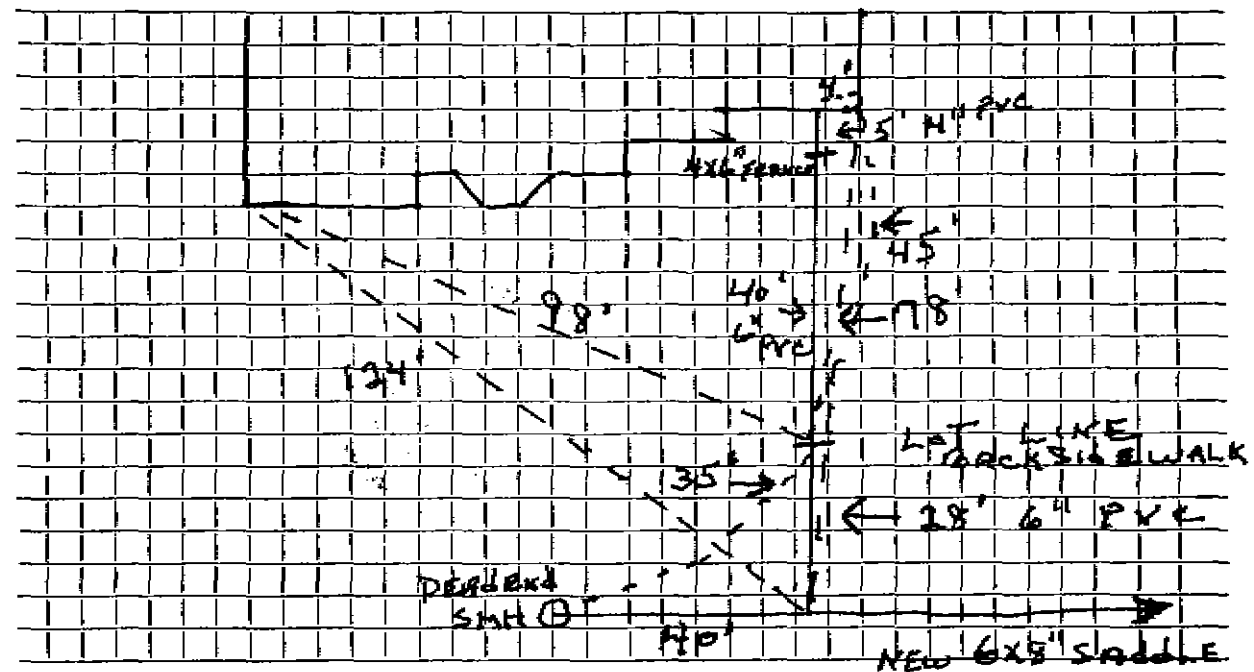

Connection made in VALLE AVE Street. Work completed

Remarks: INSTALLED BY J. McLAUGHLIN