

Service No.

Name Pond Realty Trust

Address 46 Versailles Avenue

Lot # 42 46 Vaile Avenue

Size 6"

Location

Size of Main 8"

1965

Location AUG 9

~~XXXXXXXXXXXXXXXXXXXXXXXXXXXX~~ New Service

Date		Material	Amount	Total	Date		Amount
18/65	6 1/2'	6" Transit pipe (William Burns)					
18/65	3 1/2'	6" Transit pipe (DePlice Bro.)					


TOWN OF LEXINGTON — BOARD OF PUBLIC WORKS

SEWER DIVISION

DATE \_\_\_\_\_

46

Sketch of Service Here

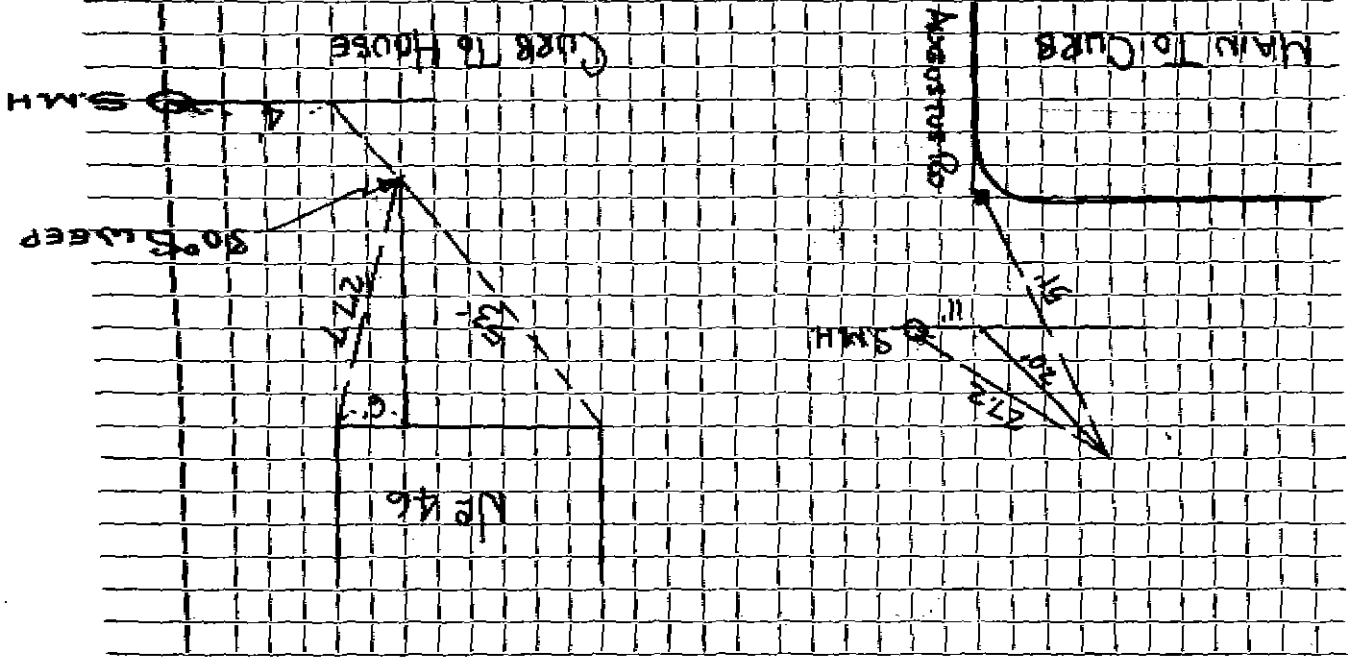

Work completed \_\_\_\_\_

Street \_\_\_\_\_

Connection made in \_\_\_\_\_

Remarks: \_\_\_\_\_