




DATE \_\_\_\_\_

TOWN OF LEXINGTON — BOARD OF PUBLIC WORKS

SEWER DIVISION

Sketch of Service Here

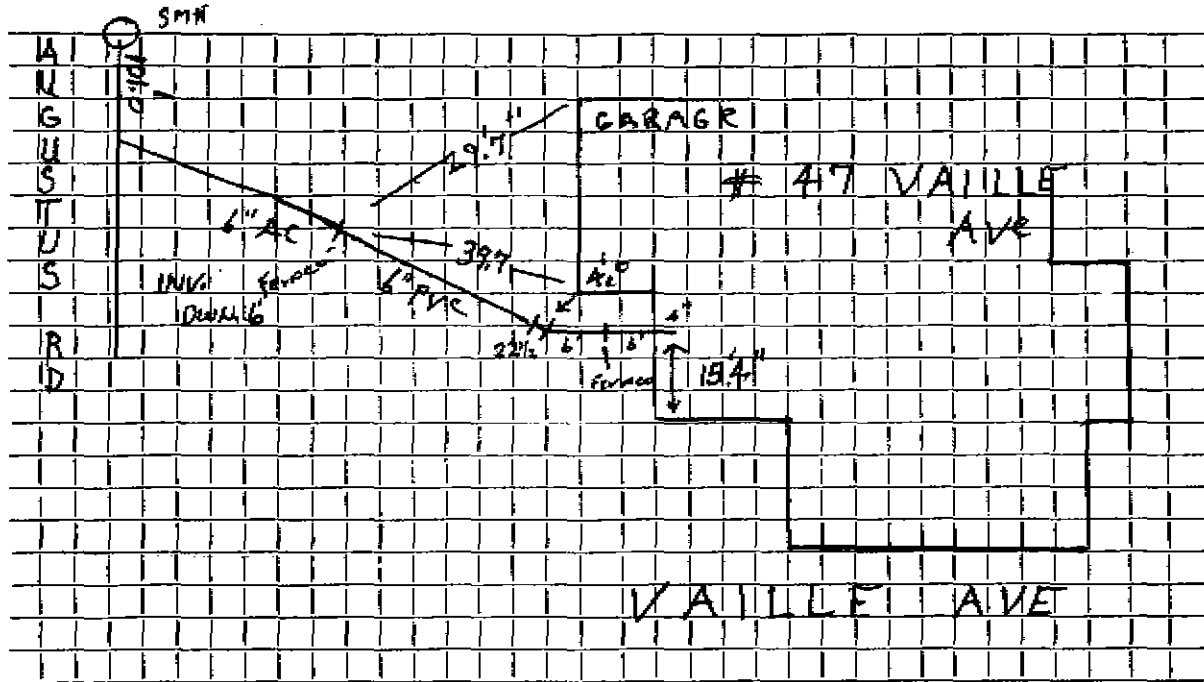

Connection made in Augustus Rd..... Street.

Work completed ... 4/4/05 ... J. McLaughlin

Remarks: (WAS #20 AUGUSTUS RD.....  
.....  
.....