

Series No. 2283


Location	Repair Removal - New Service J. McLaughlin		Size of Main 6"	Location	
Date	Material	Amount	Total	Date	Amount
10/18/66	4'6" 4" Scl 40				
19'	6" PVC				
1	4X6 Forno				
1	6" Service-Acces				
1	22.5 band				
	Inv 5.6 DUN				
12/64	30' East A.C.				

Kemal's:

Connection made in Street. Work completed /o/ /ə/ /e/ J. McLaughlin.....

Street.

8

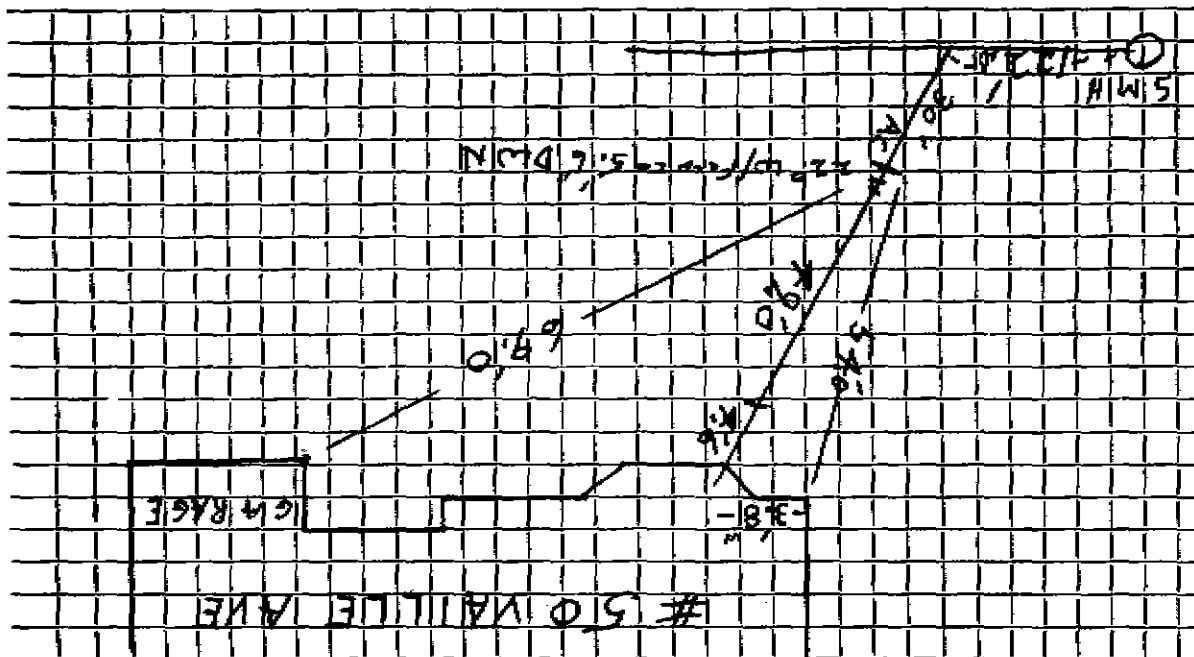

Sketch of Service Here

SEVER DIVISION

TOWN OF LEXINGTON — BOARD OF PUBLIC WORKS

-34-