

Name Alfred J. Warshaw

Service No. 77

Address 6 Vaille Avenue

6 Vaille Avenue

Location

Kind of Pipe

Size 6"

Size of Main 8"

REPAIRS - New Service

Location

Comm 7-17-61

Date	Material	Amount	Total	Date	Amount
6-25-61	Labor	44.80		6-15-61	150.00
	10% O.H.	4.48	49.28	7-17-61	37.40
59'	6" Transit pipe @.78		30.42		112.62
1	Duplex Adapter		1.62		
2	1 1/2" Transit Bends @5.10		10.20		
3	Hrs. dipping Shovel @5.00		15.00		
2	Hrs. Trucking @5.00		6.00		
			112.62		


Deposit
R.S. Fund

DATE _____

TOWN OF LEXINGTON — BOARD OF PUBLIC WORKS

SEWER DIVISION

Sketch of Service Here **6**

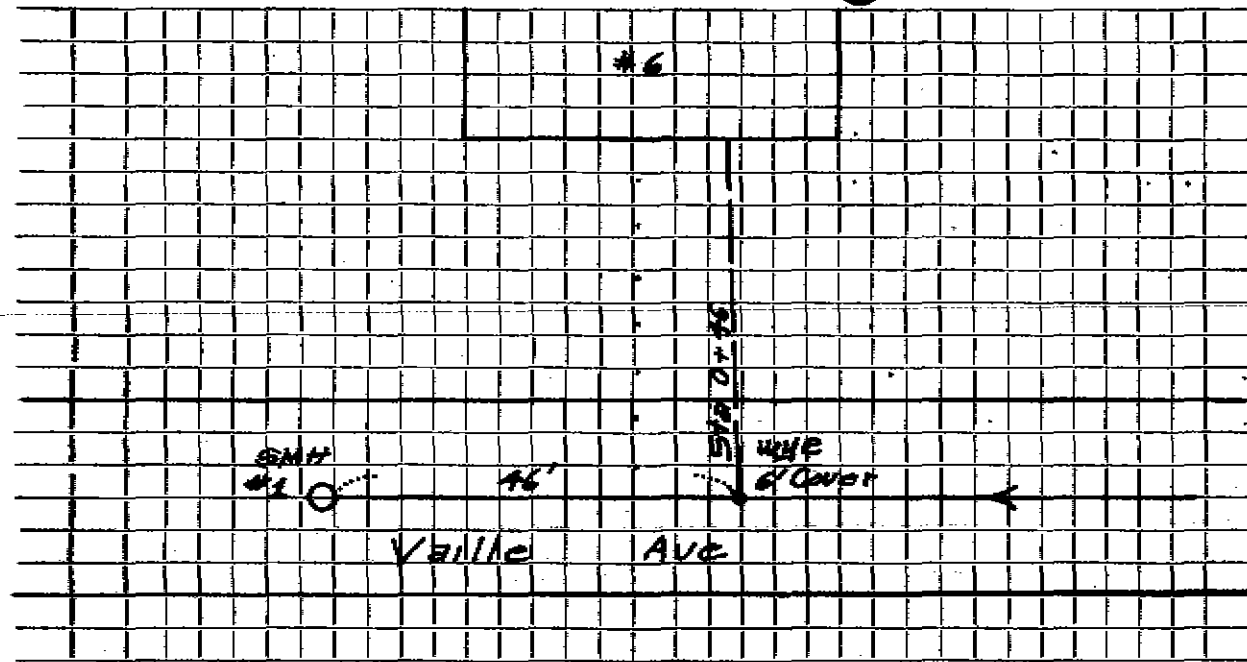

Connection made in Street. Work completed

Remarks:
.....
.....