

Name Page Associates

Service No. 77

Address

1 Valley Rd.

1 Valley Road

Location

Kind of Pipe

Size 6"

Size of Main 8"

Repair—Renewal—New Service W.O. #1108 Eagle #3107

Location FEB 10 1975


Date	Material	Amount	Total	Date	Amount
8/7/73	17' 6" Transite pipe			7-31-73	Deposit
	10' 4" Cast Iron Pipe			2-10-75	* Ret'd
8/2/73	Labor 20.75				146.15
8/7/73	" 57.44	78.19			
	10% O.H.	7.82	86.01		
	20' 6" Transite pipe @.90		18.00		
	1 8" x 6" Saddle		5.50		
	1 3' x 6" Nipple		7.45		
	1 5' x 6" Nipple w/plug		1.27		
	1 6" Plug		1.77		
	1 90° Transite Elbow		5.65		
	4 hrs. Trucking @3.00		12.00		
	3 hrs. Trucking @1.50		4.50		
	2 hrs. Town Shovel @6.50		13.00		
	1 hr. Compressor		5.00		
	1 hr. Loader		4.00		
	1 hr. Roller		2.00		
			166.15		* Applied to W.O. #59

DATE _____

TOWN OF LEXINGTON — BOARD OF PUBLIC WORKS

SEWER DIVISION

Sketch of Service Here

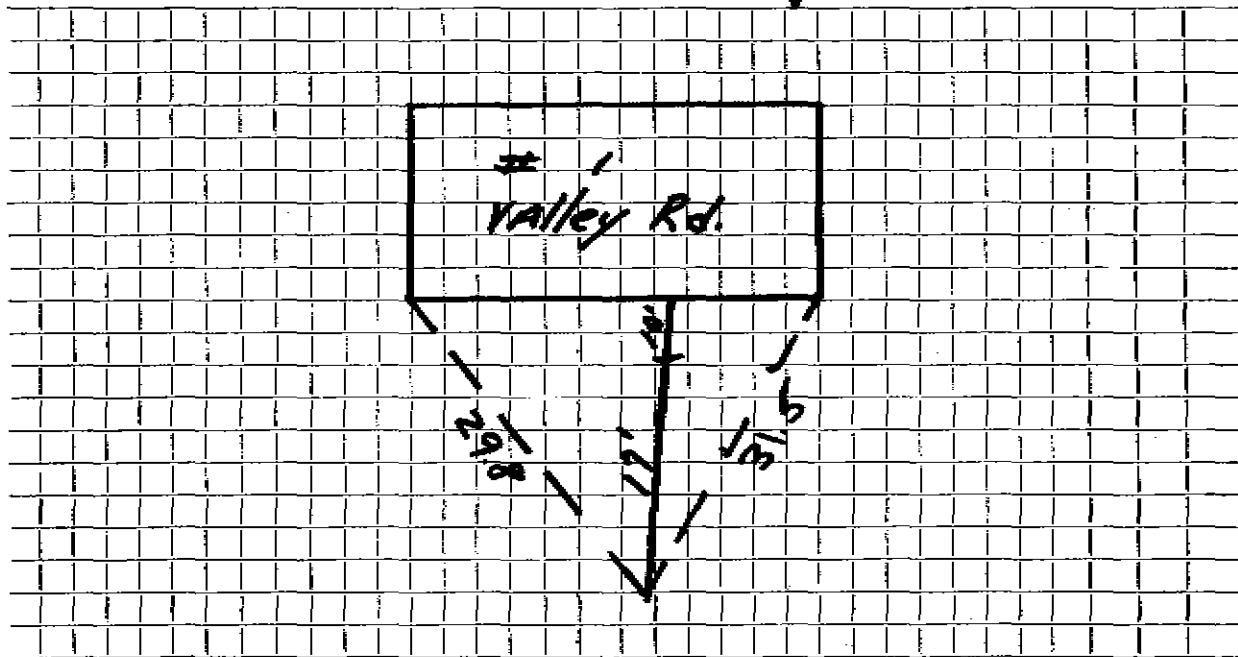

Connection made in Street. Work completed

Remarks:

.....

.....