




DATE \_\_\_\_\_

TOWN OF LEXINGTON — BOARD OF PUBLIC WORKS

SEWER DIVISION

Sketch of Service Here

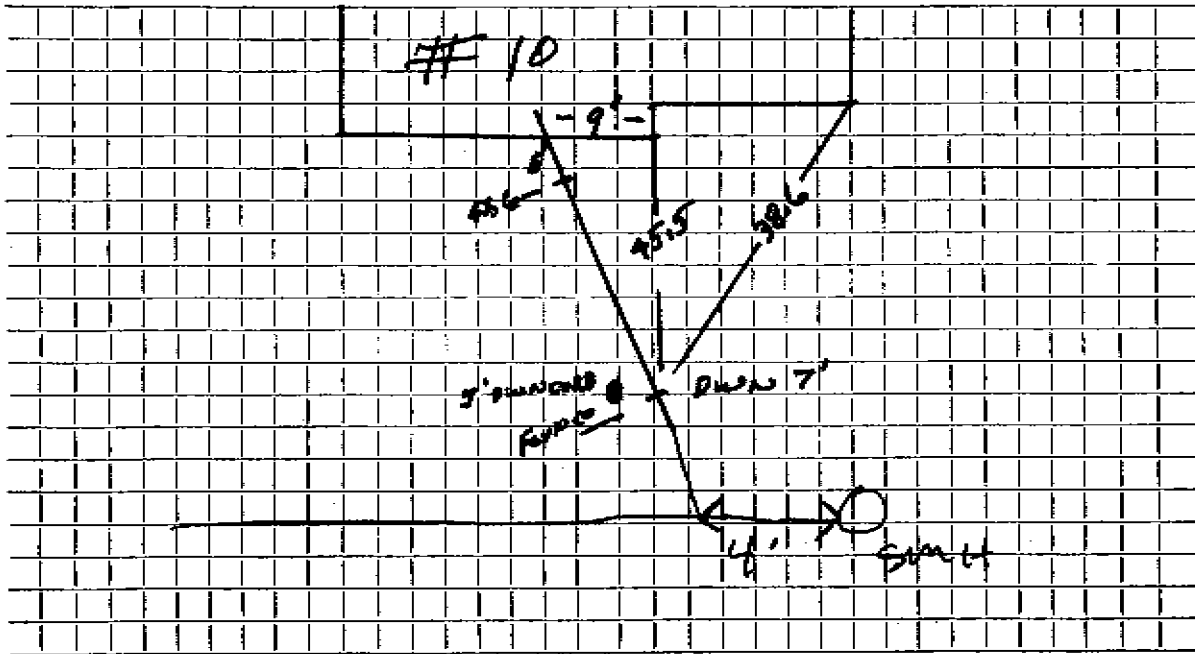

Connection made in ..... Street. Work completed .....

Remarks: CURB 2' ABOVE FURROW. WATER CROSSES SEWER .....




DATE \_\_\_\_\_

TOWN OF LEXINGTON — BOARD OF PUBLIC WORKS

SEWER DIVISION

Sketch of Service Here

10

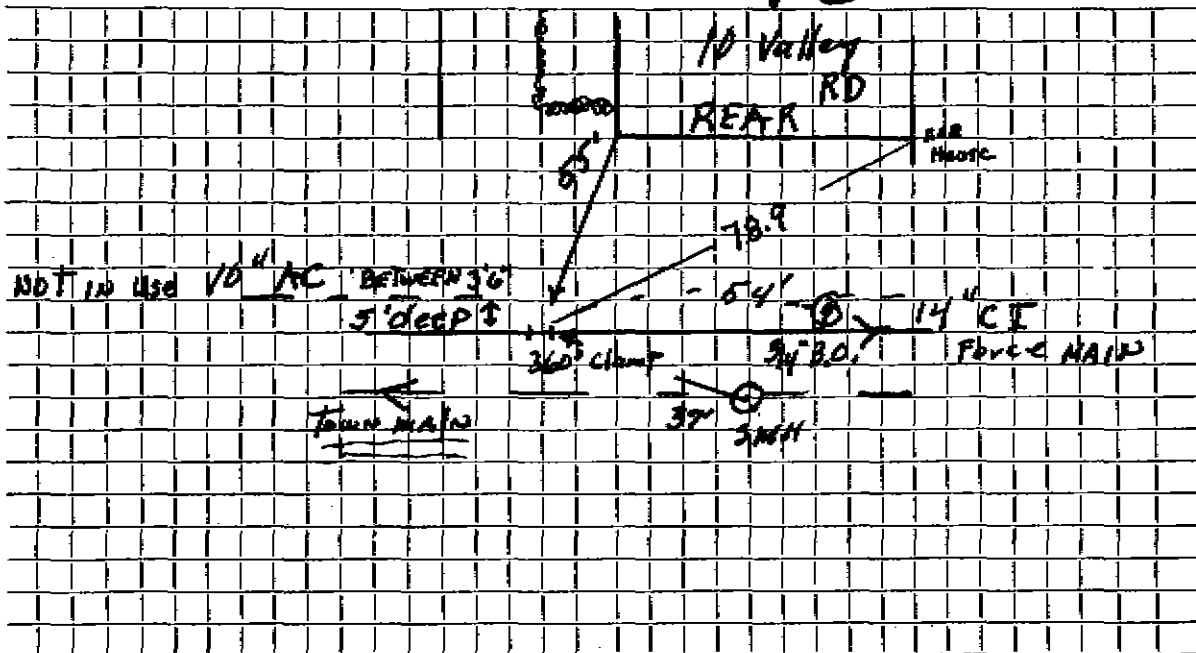

Connection made in ..... Street. " Work completed .....

Remarks: 14" CI. outside RIA. 14.30 .....

3/7/96 NEW BOTTs FOR 360° CLAMP .....



**TOWN OF LEXINGTON—DEPT. OF PUBLIC WORKS**  
**SEWER DIVISION**

DATE .....

NO. ....


The undersigned applies for the construction of a particular sewer connecting No. ....  
Street and hereby agrees to comply with the Rules and Regulations governing the construction and use of Particular  
Sewers, as now or at any future time established by the Board of Selectmen.

Am't of estimate \$.....

Am't Paid \$.....

..... Owner

**Sketch of Service Here**

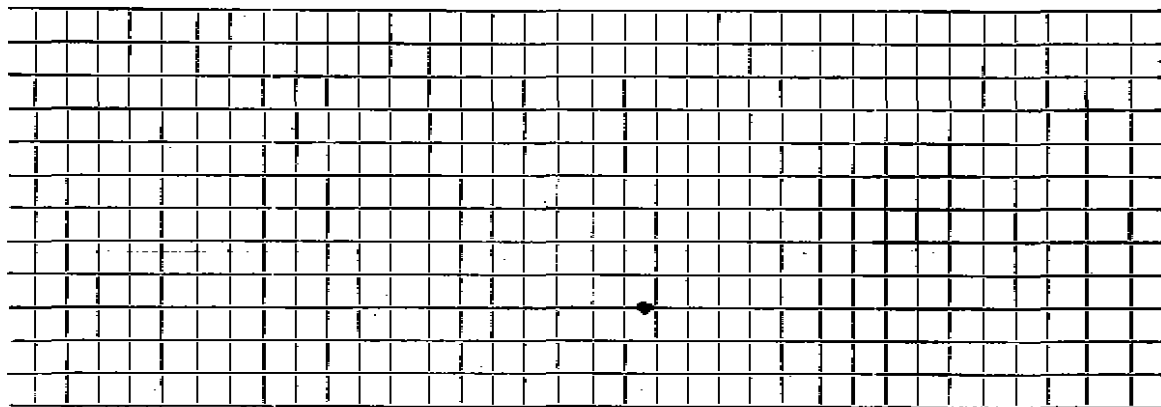

Connection made in ..... Street.

Work completed ..... 19..

Remarks:

4  
Hanna Olive E  
11 Harrington Rd  
Lexington

54-539925

Engine Number

Maker's Number

Garage

Lexington  
Commercial Gas

1-1-51

Date

3.

1940 -- Ford Cpe 2p 2d 8

Year and Model

Make and Type

Number of cylinders or total capacity

982056

3 td


Reg. No.

25

TAX LIST

Blow of for sewer No 10 Valley Rd  
 14" Force Mains Sewer Main  
 Back of house.

Valley Rd. → To Bedford St

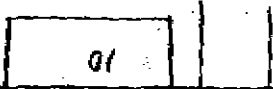

\* See other to CARD  
 REPAIR

