
Name Joseph B. Cas		brib B. Gasav						Service No. 139				
Address 18 Valley Road												
18 Valley Road				Location							·	
Kind of Pipe				OM. 8-31	Sixe	Sixe 6 "		Size of Main 8 "				
) Albert			C New Service		· 					Location		· /:
Date	Material		Material	Amount		Total		Date		Amo		unt
1/4/53	La	bor		21	50			7-29	50	Desited	125	
	J	=	erhead		15		65	d-31-	ठंउ.	Cofunded	ورم	90
	1		6" sewer pip	e 6 .30	6		57 88	 	 		95	10
	T		Littlefield	shovel@	7.5		50	:				
	1		trucking 8			li	50	# 				
	- 1	atchi	ng 15 x 3	 	ļ		00					
						95	10	il				<u> </u>
· .					<u> </u>			<u></u>			 	
-		Labo			!	<u> </u>						<u> </u>
								11-5-27		Se/ fe 18' aut		
		· .	····	 	<u>-</u>			 	<u></u>		·	
1919	- F				1	<u></u>	<u>l</u>	<u> </u>	! <u>.</u>	1	1	

TOWN OF LEXINGTON-DEPT, OF PUBLIC WORKS

SEWER DIVISION

NO
-
use of Particular
Owner
•

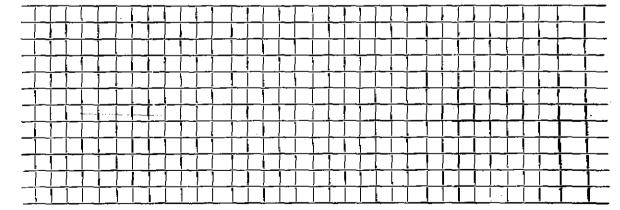

Connection made in Street.

Remarks: