

Name **Angelo Lanni**Service No. **147**Address **21 Valley Road****21 Valley Road**

Location

Kind of Pipe

Size **6"**Size of Main **8"**~~Repair~~ **Renewal** ~~New Service~~Location **FEB 15 1965**

Date	Material	Amount	Total	Date	Amount
-7-64	Labor 83.98			9-3-64	Deposit 125.00
-8-64	Labor 7.50	91.48		2-15-65	Retard 42.60
	10% O.H.	9.15	100.63		82.40
	30' 6" Transite pipe @ .82		24.60		
	1 Bag Cement		1.50		
	1 Yd. Loam		3.00		
	1 90° Elbow		4.09		
	1 6" Transite Nipple		1.65		
	1 Duplex Adapter		1.62		
	10 x 3 Patch		10.00		
	2 Hr. Town Truck @ 3.00		6.00		
	1 Hr. Town Shovel		6.50		
			159.59		
	PRO-RATED 159.59 x 12.11 =		82.40		
	25				
.18501				8-26-64	Roots


DATE \_\_\_\_\_

TOWN OF LEXINGTON — BOARD OF PUBLIC WORKS

SEWER DIVISION

Sketch of Service Here

21

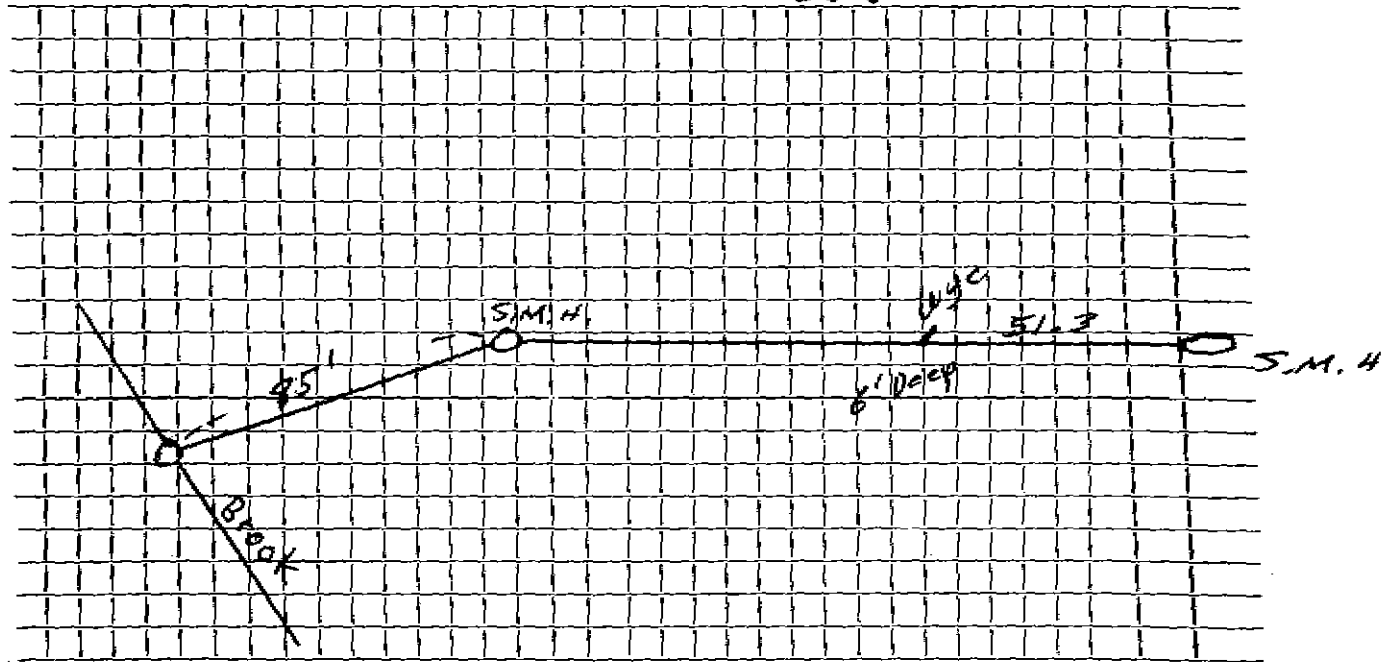

Connection made in ..... Street. Work completed .....

Remarks: Original Service 10-30-51 (50'-6" Sewer Pipe) .....