

Name **Richard Moroney**

Service No.

151

Address **25 Valley Rd.**Lexington **25 Valley Road** Location

Kind of Pipe

Size **6"**Size of Main **8"**~~XXX Repair XXX~~ **New Service****Committed 12-8-52**

Location

Date	Material	Amount	Total	Date	Amount
10/29/52	Labor	37 65		9-30-52 Deposited	175 00
10/30/52	Labor	52 71		12-8-52 Refunded	18 41
	10% Overhead	9 04	99 40		156 59
	44' - 6" sewer pipe @ .342		15 05		
	Joint compound		2 64		
	5 hrs. town shovel @ 5.00		25 00		
	2 hrs. trucking @ .75		1 50		
	patching 13 X 3		13 00		
			156 59		
	Labor				

TOWN OF LEXINGTON—DEPT. OF PUBLIC WORKS

SEWER DIVISION

DATE

NO.


The undersigned applies for the construction of a particular sewer connecting No. Street and hereby agrees to comply with the Rules and Regulations governing the construction and use of Particular Sewers, as now or at any future time established by the Board of Selectmen.

Am't of estimate \$.....

Am't Paid \$.....

..... Owner

Sketch of Service Here

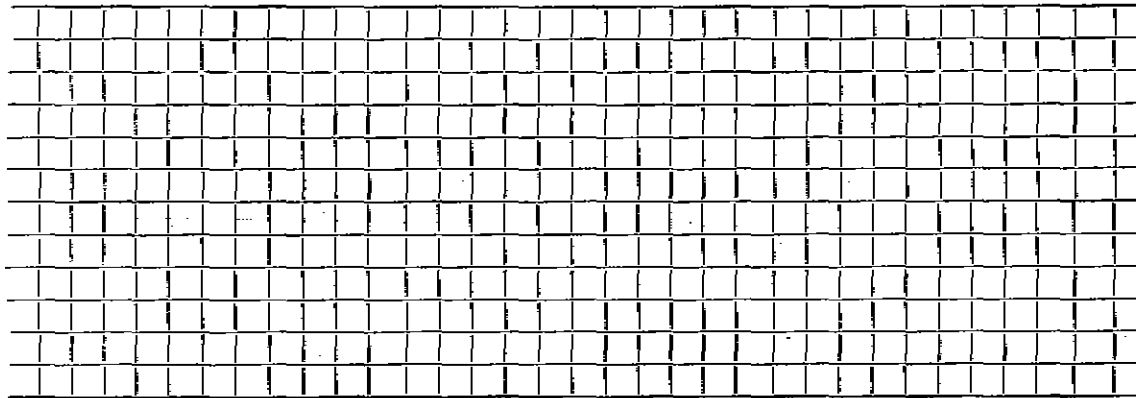

Connection made in Street.

Work completed 19..

Remarks: