

Name. Emory D. Heald

Service No. 2.

Address 3 Valley Road

3 Valley Road

Location 3 Valley Road

Kind of Pipe

Size 6"

Size of Main 8"

~~XXXXXXXXXX~~ - New Service

Conn. 5/22/51

Location

Date	Material	Amount.	Total	Date	Amount
4/4/51	Labor	44 46	44 46	1-15-51	Deposited 152 00
	10% overhead	4 45	4 45	8-2-51	Deposited 17 97
	34' - 6" Sewer Pipe @ .344		11 70		132 05
	1 - 6" Elbow		1 88		
	Joint Compound		2 04		
	8 hrs. Littlefield Shovel		56 00		
	2 hrs. Trucking		1 50		
	Patching 10x3		10 00		
			132 03		
	Labor				

TOWN OF LEXINGTON—DEPT. OF PUBLIC WORKS

SEWER DIVISION

DATE

NO.


The undersigned applies for the construction of a particular sewer connecting No.
Street and hereby agrees to comply with the Rules and Regulations governing the construction and use of Particular
Sewers, as now or at any future time established by the Board of Selectmen.

Am't of estimate \$.....

Am't Paid \$.....

..... Owner

Sketch of Service Here

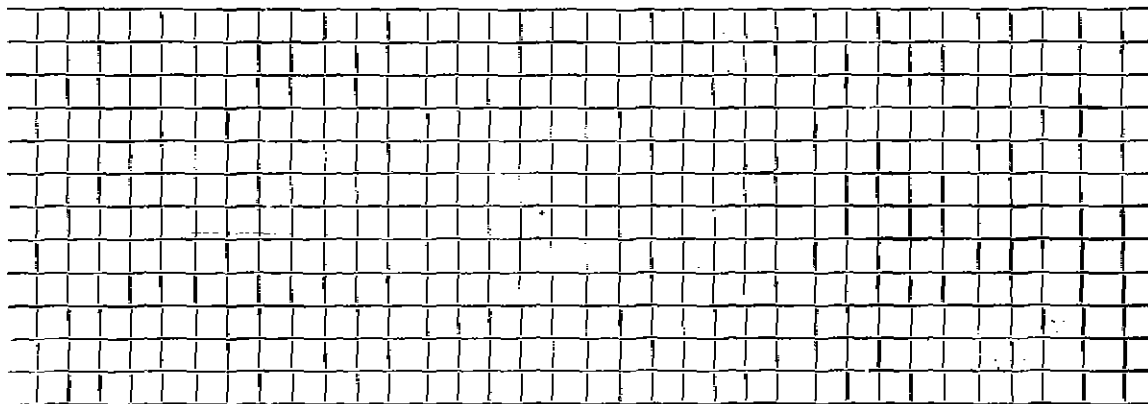

Connection made in Street.

Work completed 19..

Remarks: