

Name

Service No.

Address

34 Valley Rd

Location

Kind of Pipe

Size

Size of Main

Repair—Renewal—New Service

Location

Date	Material	Amount	Total	Date	Amount
7.26.04	42'-6" PVC			9/27/2	
	6x6 PVC to AC	Pigued			
	4x6 PVC to PVC	Pigued			


21'-6" Transite  
6x8 w/r

DATE \_\_\_\_\_

TOWN OF LEXINGTON — BOARD OF PUBLIC WORKS

SEWER DIVISION

Sketch of Service Here

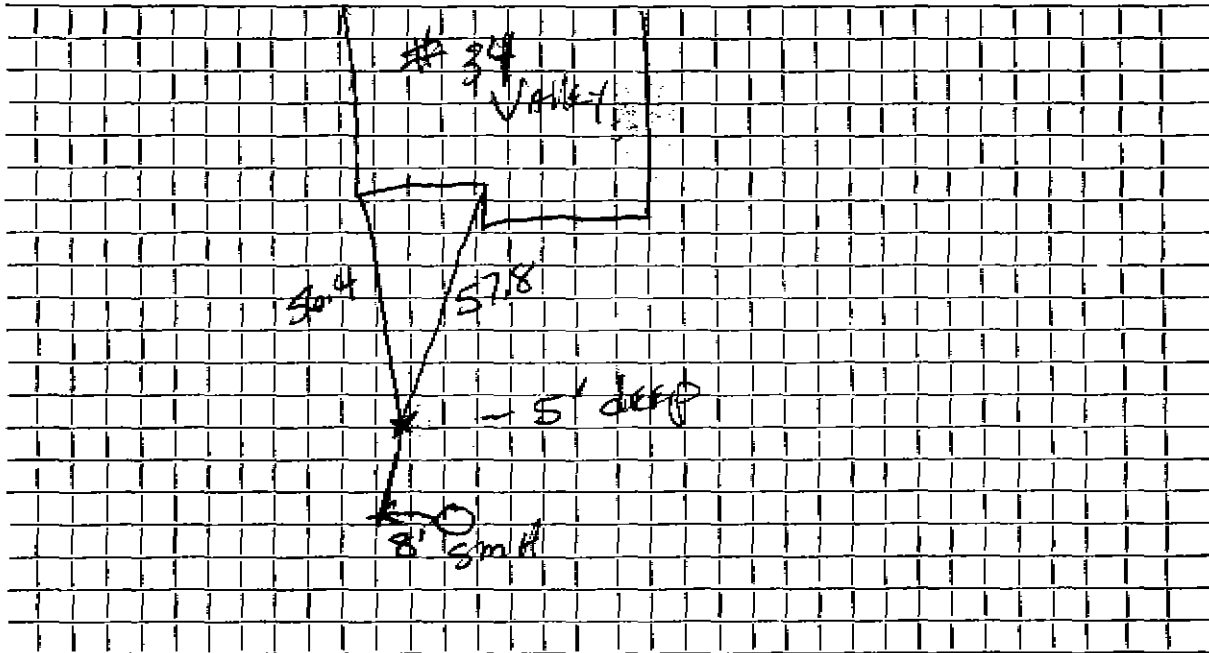

Connection made in ..... Street. Work completed .....

Remarks: .....

.....

.....