


DATE MARCH 12, 1997

TOWN OF LEXINGTON — BOARD OF PUBLIC WORKS

SEWER DIVISION

Sketch of Service Here **63**

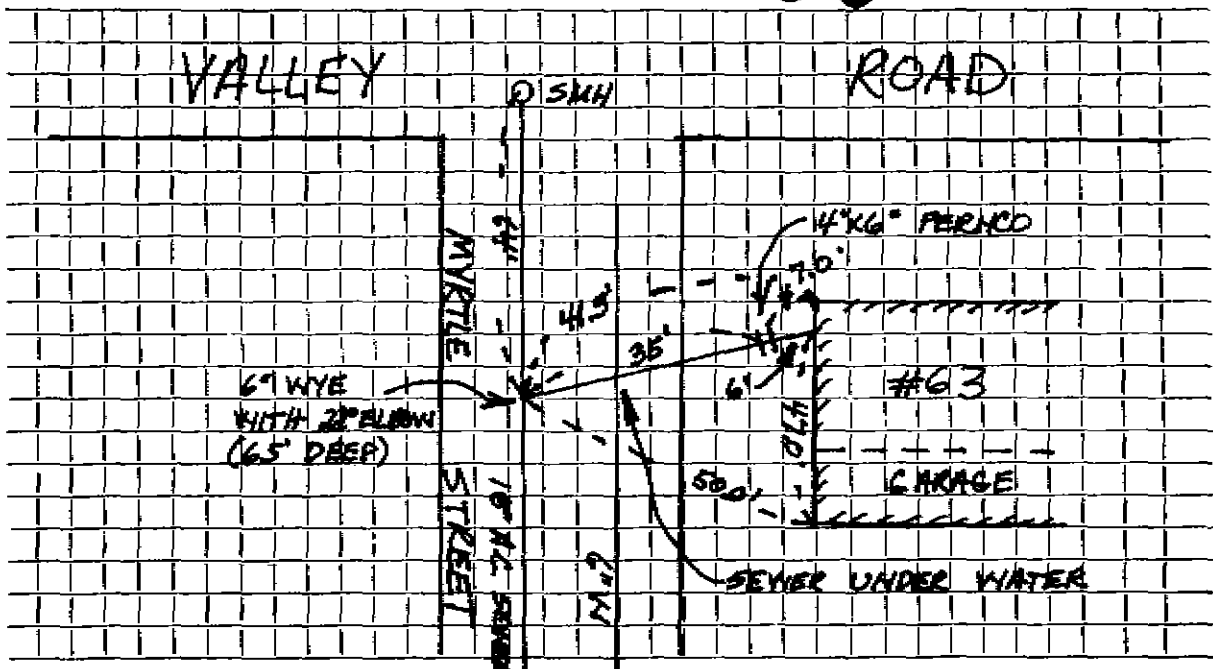

Connection made in VALLEY ROAD/MYRTLE STREET Street.

Work completed J.M. MCLAUGHLIN

Remarks: