


DATE _____

TOWN OF LEXINGTON — BOARD OF PUBLIC WORKS

SEWER DIVISION

Sketch of Service Here **67**

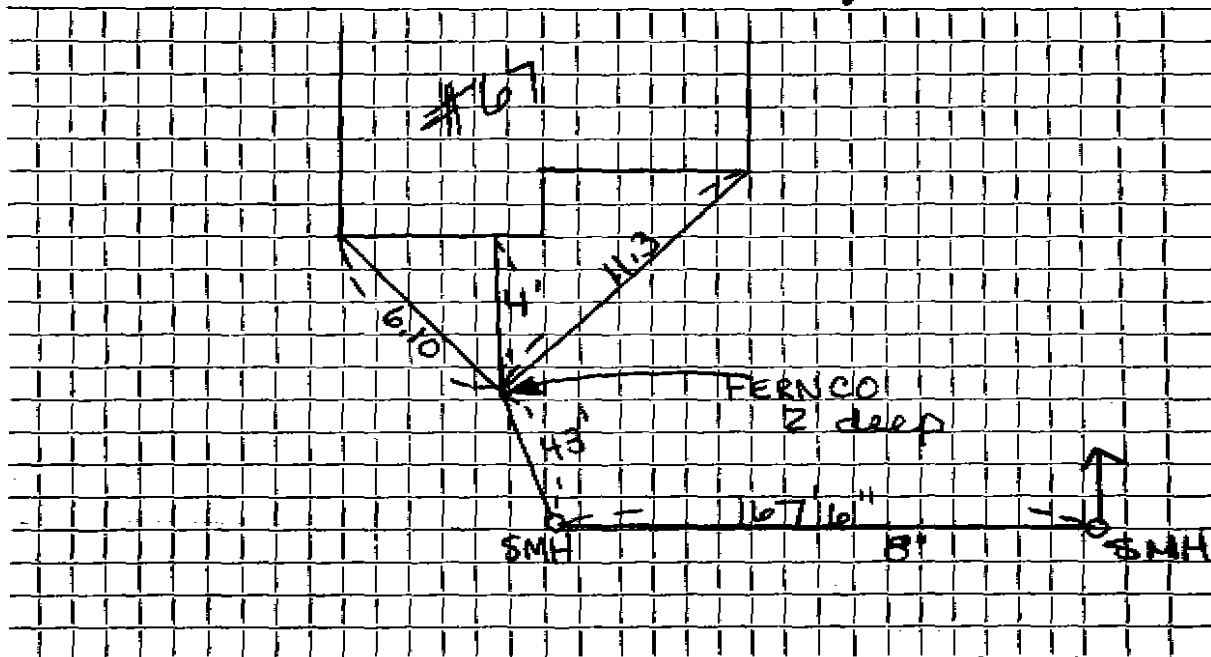

Connection made in VALLEY RD Street. Work completed

Remarks: 8" to manhole 6" service