



DATE 6/26/90


TOWN OF LEXINGTON — BOARD OF PUBLIC WORKS

P.A.B.

SEWER DIVISION

68

Sketch of Service Here

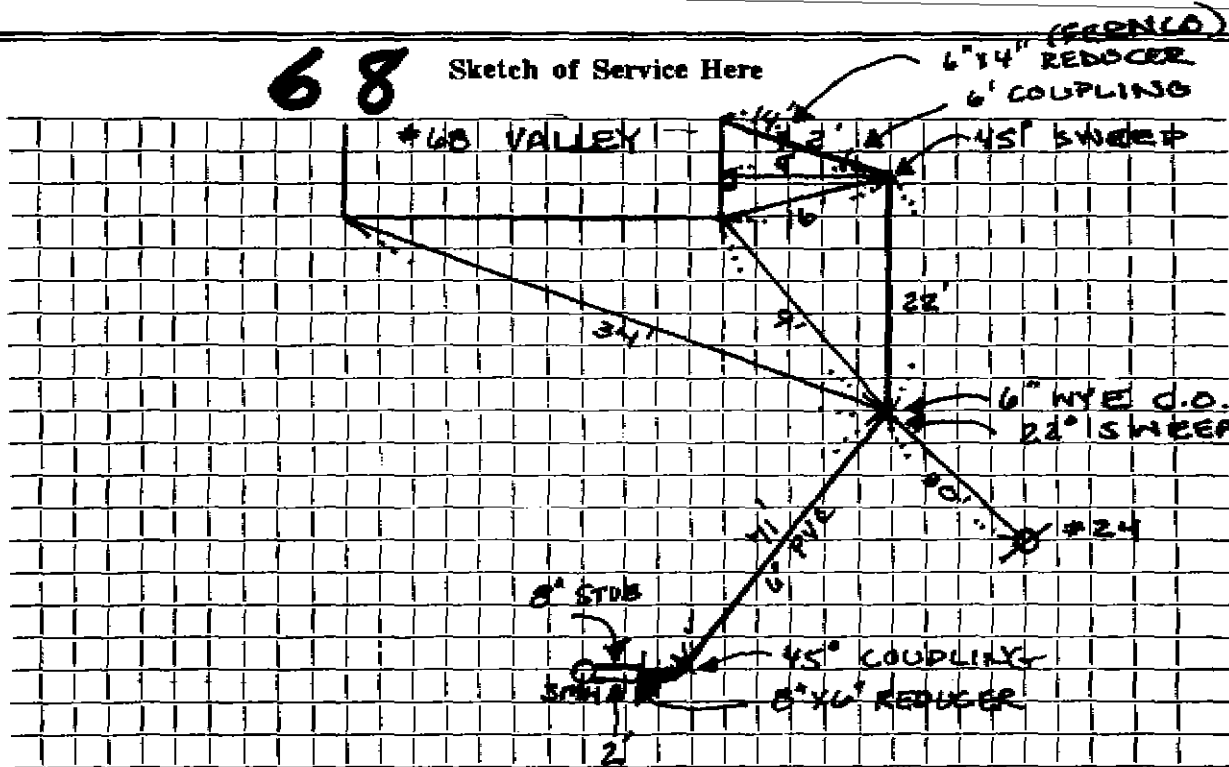

Connection made in VALLEY Rd. Street. Work completed .....

Remarks: INSPECTED: P.A. BARROWS  
CONTRACTOR: A. CIERI & SONS