

Name

Address

100 Valleyfield Street

Service No.

Lot #70 100 Valleyfield Street Location

Kind of Pipe

Size 6"

Size of Main 24"

Repair—Renewal—New Service


Location

Date	Material	Amount	Total	Date	Amount

DATE _____

TOWN OF LEXINGTON — BOARD OF PUBLIC WORKS
SEWER DIVISION

Sketch of Service Here **100**

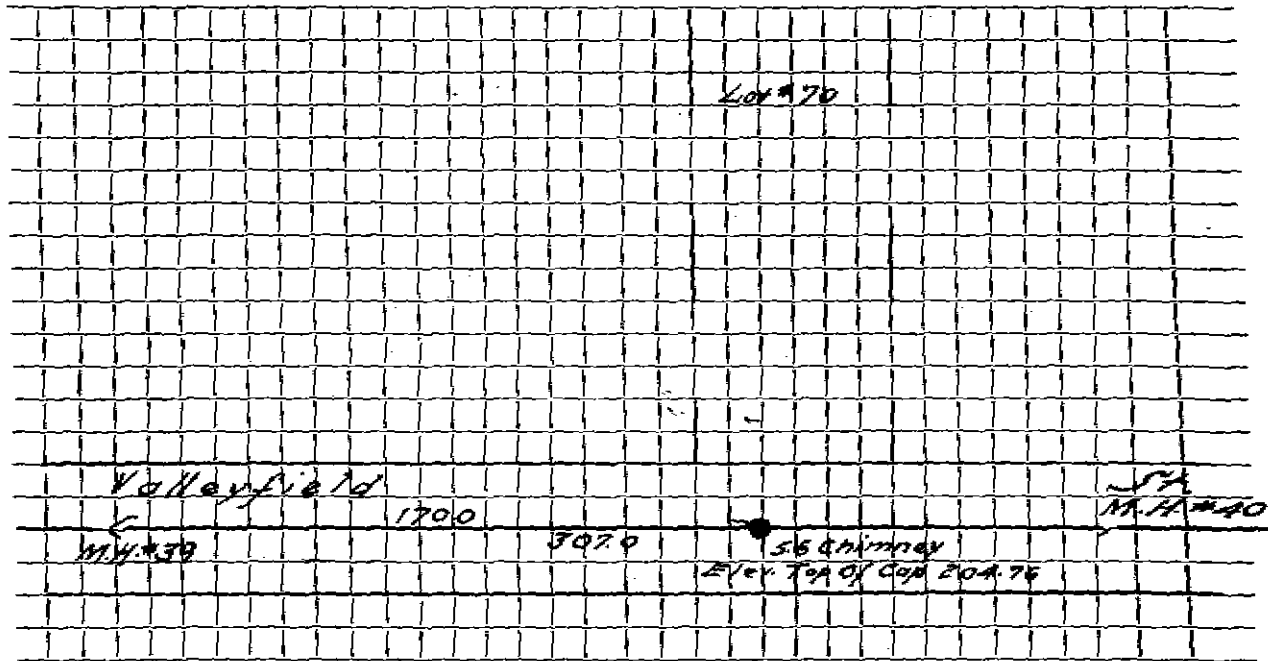

Connection made in Street. Work completed

Remarks:

.....

.....