

Name

Service No.

Address 101 Valleyfield Street

Lot #63 101 Valleyfield ST. Location

Kind of Pipe Size 6"

Size of Main 24"

Repair—Renewal—New Service

Location


Date	Material	Amount	Total	Date	Amount

DATE \_\_\_\_\_

TOWN OF LEXINGTON — BOARD OF PUBLIC WORKS  
SEWER DIVISION

Sketch of Service Here

101

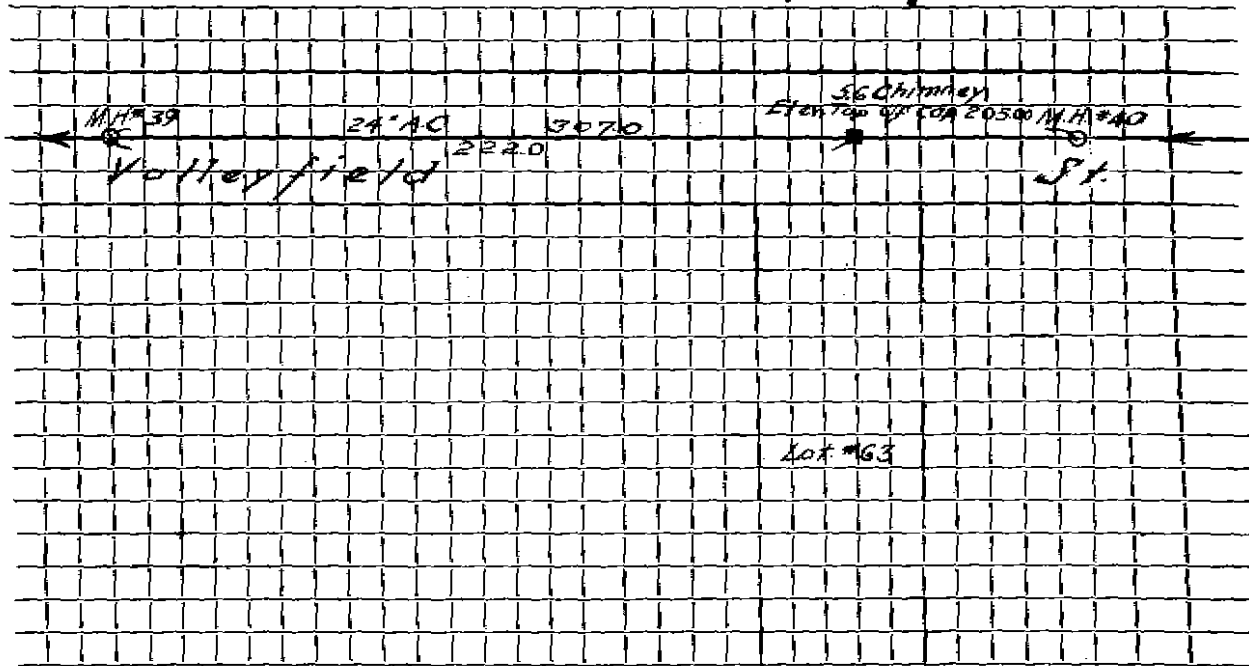

Connection made in ..... Street. Work completed .....

Remarks: .....

.....

.....