


DATE _____

TOWN OF LEXINGTON — BOARD OF PUBLIC WORKS

SEWER DIVISION

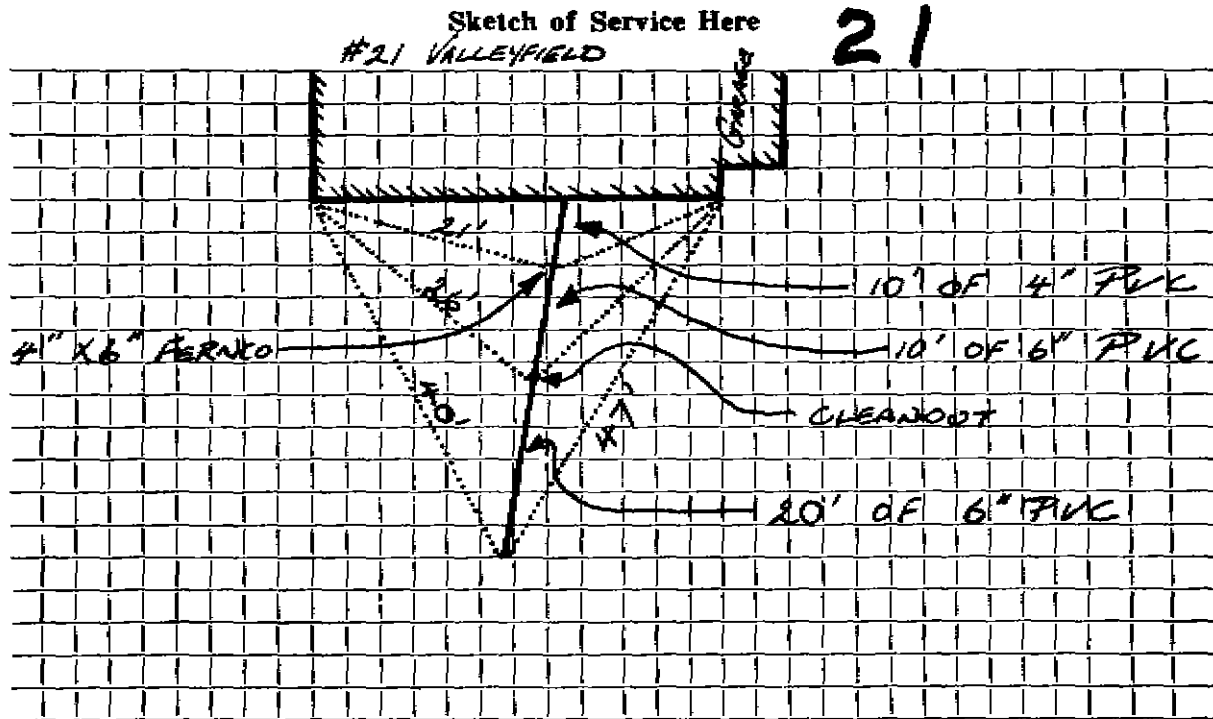

Connection made in ... VALLEYFIELD Street. Work completed

Remarks:
.....
.....