




DATE \_\_\_\_\_

TOWN OF LEXINGTON — BOARD OF PUBLIC WORKS

SEWER DIVISION

Sketch of Service Here **24**

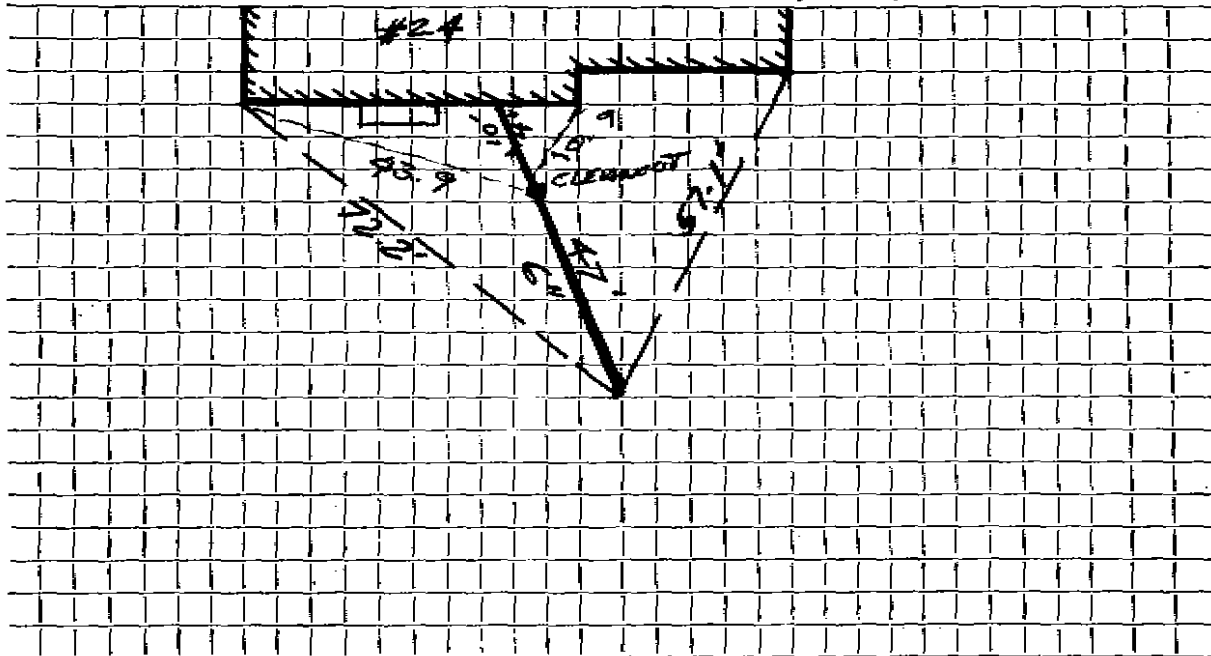

Connection made in VALLEY FIELD Street. Work completed .....

Remarks: NO OUTSIDE TIES .....

.....  
.....