

Name Robert Pheban

Service No.

Address 25 Valleyfield Street

25 Valleyfield Street

Location

Kind of Pipe

Size 6"

Size of Main 8"

Repair—Renewal—New Service

Redmond #4269

Location


Date	Material	Amount	Total	Date	Amount
1990	60' 6" PVC				
	10' 4" PVC				
	4" x 6" Ferrico				

DATE \_\_\_\_\_

TOWN OF LEXINGTON — BOARD OF PUBLIC WORKS

SEWER DIVISION

Sketch of Service Here #25 VALLEYFIELD 25

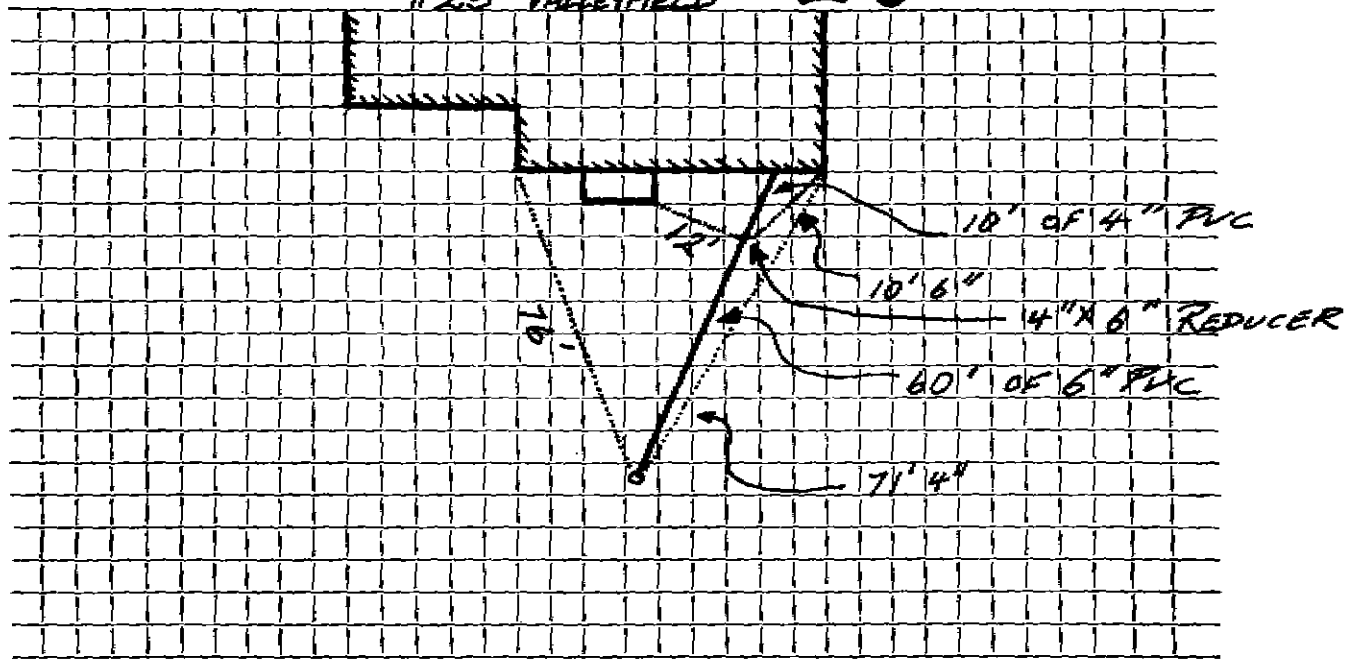

Connection made in VALLEYFIELD Street. Work completed .....

Remarks: NO OUTSIDE TIES .....