

Name **William F. Hopkins**

Service No. 165

Address **27 Valleyfield Street**

Lot #165 **27 Valleyfield Street** Location

Kind of Pipe

Size **6"**

Size of Main **8"**


Repair—~~Removal~~—New Service **Nicholas Bonanno # 502**

Location **SEP 5 1967**

Date	Material	Amount	Total	Date	Amount
1966 21*	6" Transite pipe @5.00	5.00	105.00	11-7-66	105.00
<del>1/6/66</del> 1/9/66	38 * 6" Transite				

SEWER DIVISION

Sketch of Service Here  
**27**

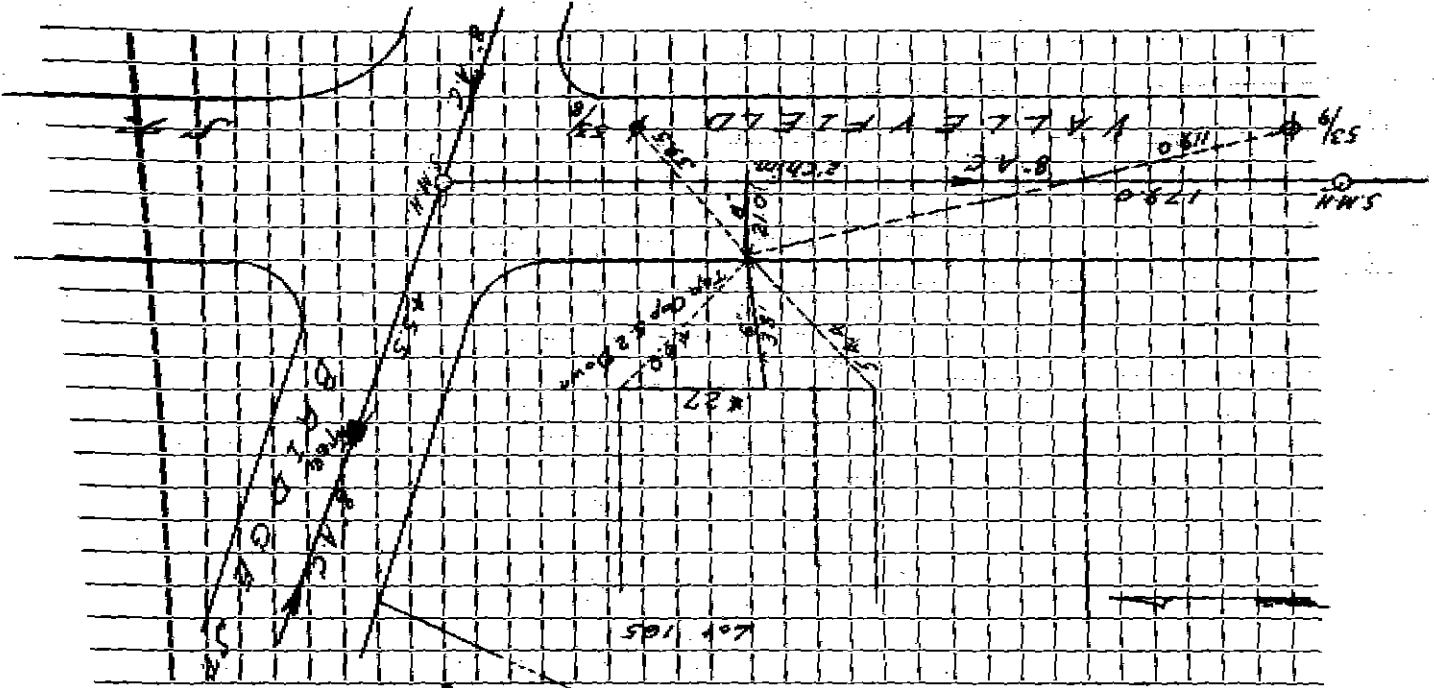

Street. Work completed

Connection made in  
 Remarks: