

**Naugmerson Construction Company**

Service No. 61

Address 31 Valleyfield Street

**31 Valleyfield Street**

Location

Kind of Pipe

Size 6"

Size of Main 8"

Repair—Renewal—New Service

Location OCT 25 1976

Date		Material	Amount		Total	Date		Amount
'66	21'	6" Transite pipe @ 5.00			105.00	6-18-75	Deposit	167.30
1/67		Labor	34	36				
		10% O.H.	3	44	37.80			
	10'	6" transite pipe @ .88			8.80			
	2	Ton 3/4" Stone @ 1.60			3.20			
	2	Hrs. Trucking @ 3.00			6.00			
	1	Hr. Shovel			6.50			
					<del>105.00</del>			
		<b>BILL WHEN CONNECTED</b>			167.30			


DATE \_\_\_\_\_

TOWN OF LEXINGTON — BOARD OF PUBLIC WORKS

SEWER DIVISION

Sketch of Service Here

31

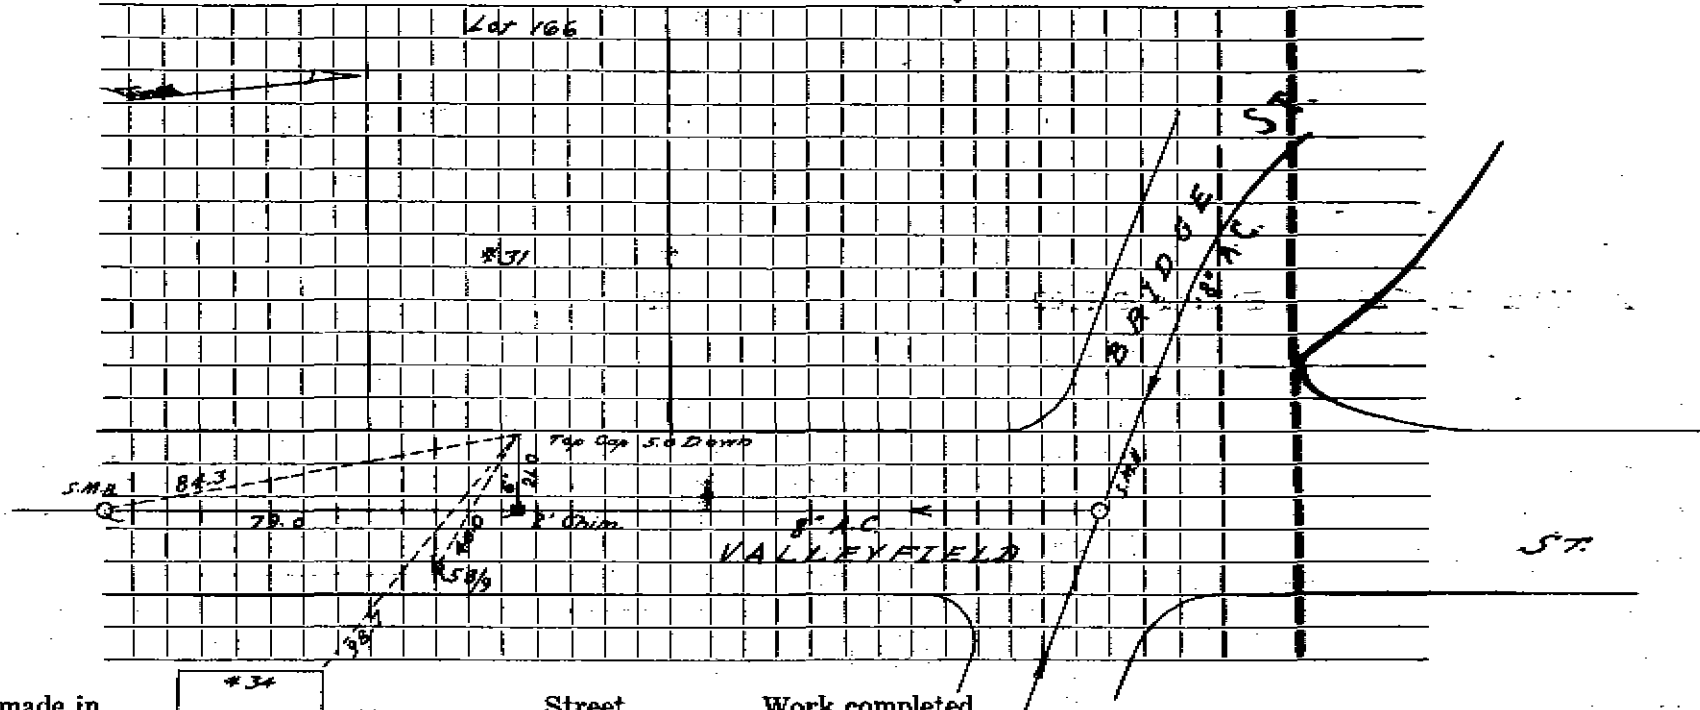

Connection made in

#31

Street.

Work completed

Remarks:

.....  
.....  
.....