

Name *None*

Service No.

Address *33 Valleyfield Street*

*33 Valleyfield Street*

Location

Kind of Pipe

Size *6"*

Size of Main *8"*

Repair—Renewal—New Service


Location

Date		Material	Amount	Total	Date	Amount
'66	21	6" Transite pipe @ 5.00		105.00		
11/67		Labor	34 36			
		10% O.H.	3 44	37 80		
	10	6" Transite pipe @ <del>28x</del> .88		8 80		
	1	Ton 3/4" stone		1 60		
	2	Hrs. Trucking @ 3.00		6 00		
	1	Hr. Shovel		6 50		
				<del>168 80</del>		
		BILL WHEN CONNECTED		165 70		

DATE \_\_\_\_\_

**TOWN OF LEXINGTON — BOARD OF PUBLIC WORKS**  
**SEWER DIVISION**

Sketch of Service Here **33**

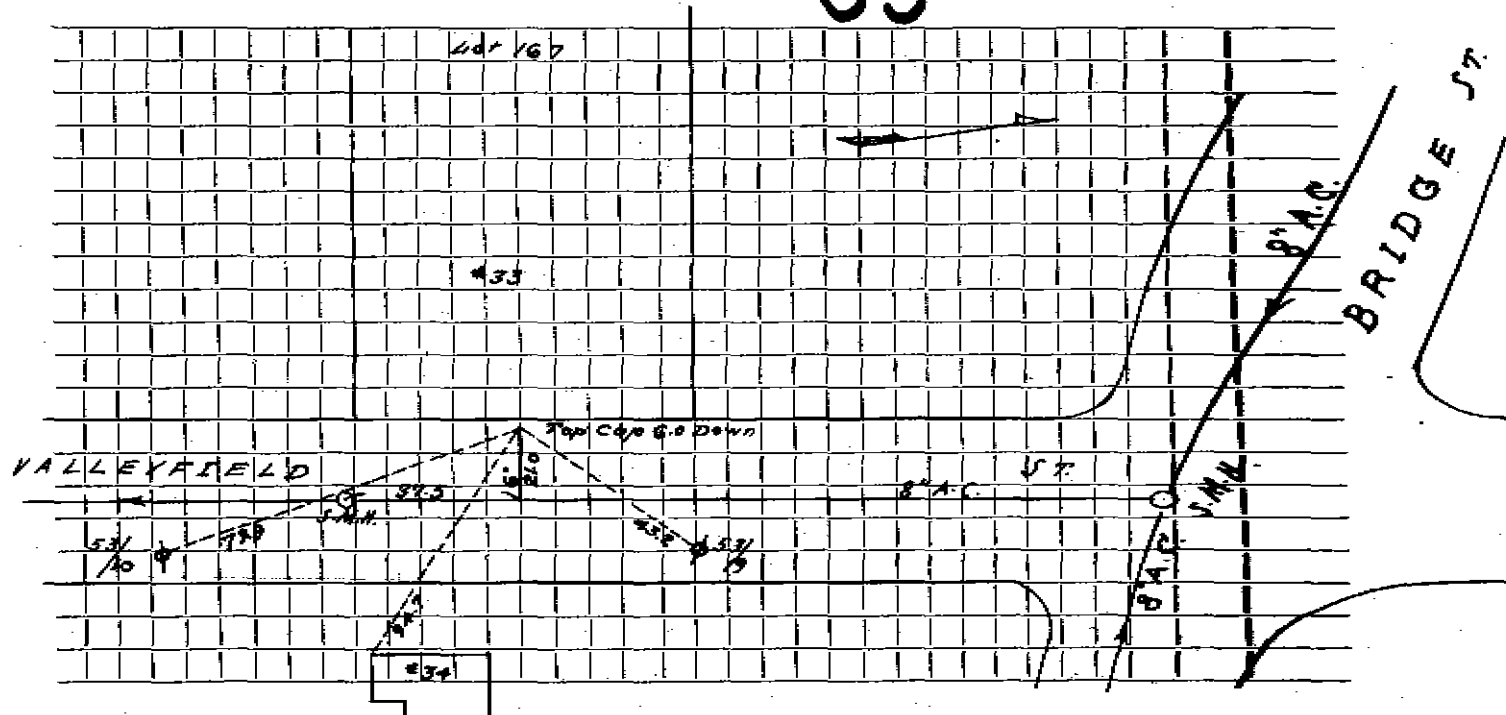

Connection made in ..... Street. Work completed .....

Remarks: .....  
 .....  
 .....