

Name *Richard O'Keefe*

Service No. 54

Address *34 Valleyfield Street*

34 Valleyfield Street

Location

Kind of Pipe

Size *6"*

Size of Main *8"*

~~Repair~~ ~~Renewal~~ *New Service* Arlex #3857

Location FEB 27 1984

Date		Material	Amount	Total	Date	Amount
L '66	21'	6" Transite pipe @	5.00	105.00	11-1-83	Deposit
2/83	44'	6" P.V.C.				125.00
	2	22° Bends				
	7'	4" P.V.C.				
		4" x 6" Donut				


DATE _____

TOWN OF LEXINGTON — BOARD OF PUBLIC WORKS

SEWER DIVISION

Sketch of Service Here

34

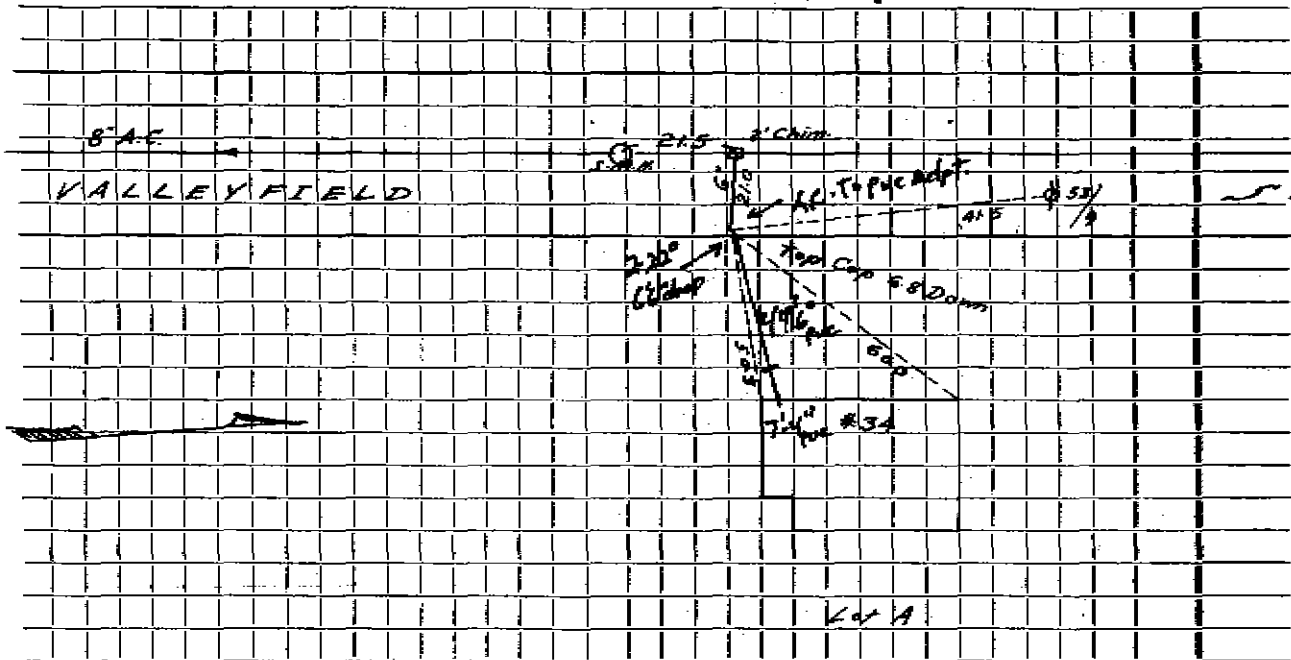

Connection made in Street. Work completed

Remarks:

.....

.....