

Name **Edward Domings**

Service No. 72

Address **37 Valleyfield Street**

Lot 168-169-170 **37 Valleyfield Rd.** Location

Kind of Pipe

Size **6"**

Size of Main **8"**

Repair—Renewal—New Service **Bonanno#682**


Location **AUG 5 1968**

Date		Material	Amount	Total	Date		Amount
'66	21	6" Transite pipe	5.00	105.00	1-33-67	<i>Deposited</i>	105.00
5-67	44	6" Transite pipe					
	10	4" Cast Iron pipe					

DATE _____

TOWN OF LEXINGTON — BOARD OF PUBLIC WORKS
SEWER DIVISION

Sketch of Service Here **37**

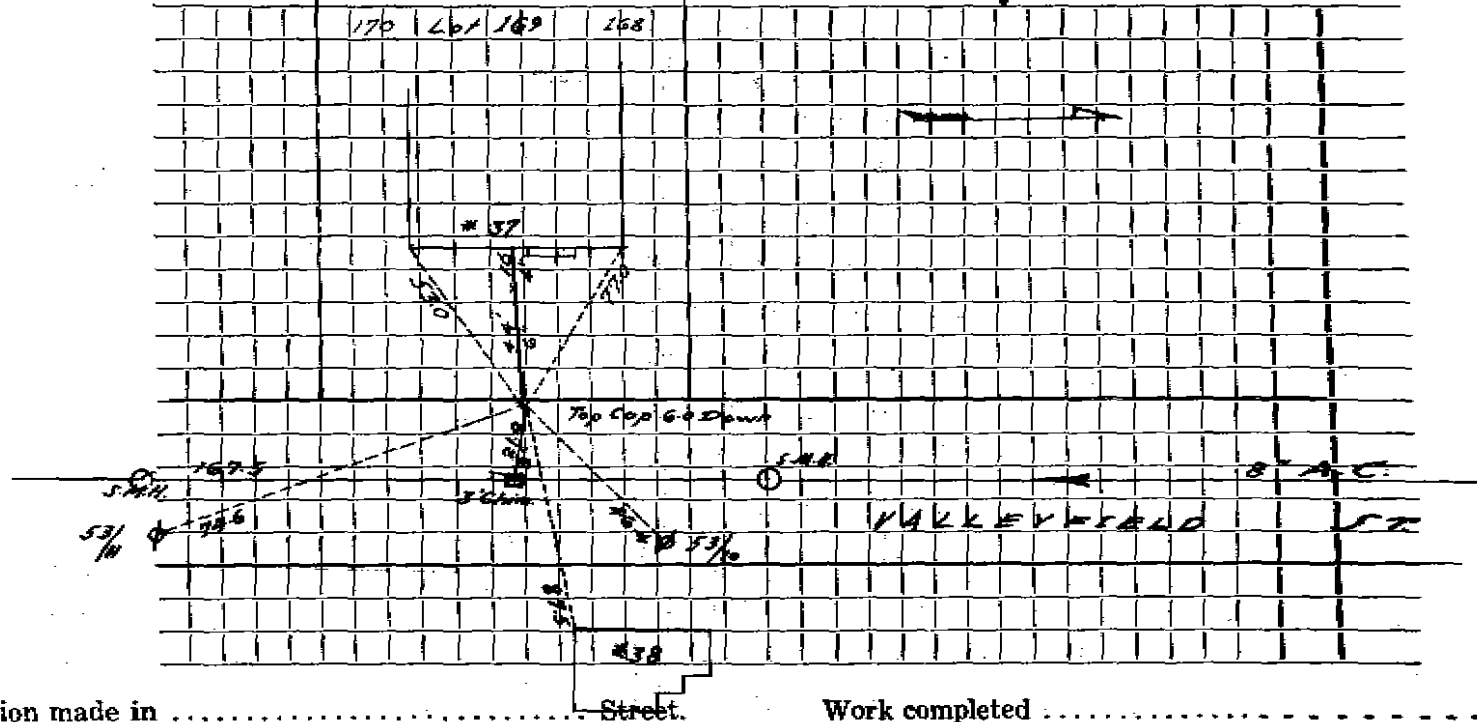

Connection made in Street. Work completed

Remarks:
.....
.....