




DATE 9-21-94

TOWN OF LEXINGTON — BOARD OF PUBLIC WORKS

### SEWER DIVISION

Sketch of Service Here **39**

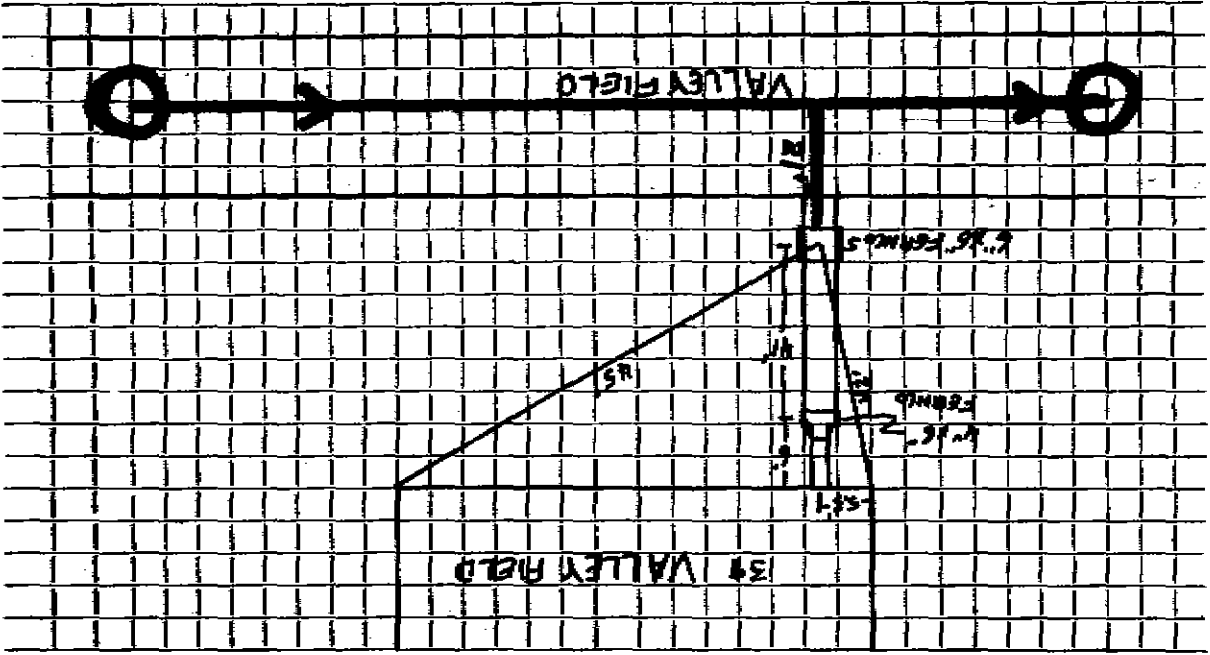

Connection made in VALLEY FIELD Street. Work completed

Remarks: